


Give All Information Completely
Make Required Affidavit
Mail or Deliver Report to:
Conservation Division
State Corporation Commission
211 No. Broadway
Wichita, Kansas

WELL PLUGGING RECORD

Barber County, Sec. 35 Twp. 33 Rge. (E) 14W (W)
Cen. SW/4

Location as "NE/CNWKSWK" or footage from lines _____
Lease Owner Lario Oil & Gas Company
Lease Name Lenkner Well No. 1
Office Address 301 South Market, Wichita, Kansas
Character of Well (completed as Oil, Gas or Dry Hole) Dry Hole
Date well completed August 25 1965
Application for plugging filed (verbal) August 25 1965
Application for plugging approved (verbal) August 25 1965
Plugging commenced August 25 1965
Plugging completed August 25 1965
Reason for abandonment of well or producing formation Dry

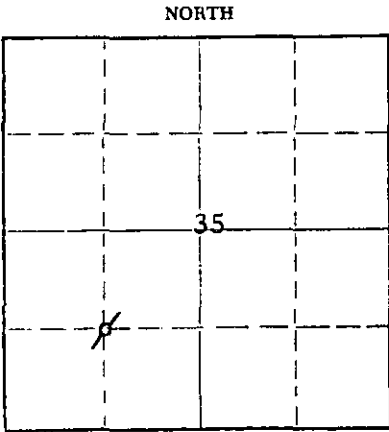

Locate well correctly on above Section Plat

If a producing well is abandoned, date of last production _____ 19____
Was permission obtained from the Conservation Division or its agents before plugging was commenced? Yes

Name of Conservation Agent who supervised plugging of this well Archie V. Elving
Producing formation _____ Depth to top _____ Bottom _____ Total Depth of Well 4863 Feet
Show depth and thickness of all water, oil and gas formations.

OIL, GAS OR WATER RECORDS

CASING RECORD

FORMATION	CONTENT	FROM	TO	SIZE	PUT IN	PULLED OUT
				8 5/8"	396.87'	Set @ 401'

Describe in detail the manner in which the well was plugged, indicating where the mud fluid was placed and the method or methods used in introducing it into the hole. If cement or other plugs were used, state the character of same and depth placed, from _____ feet to _____ feet for each plug set.

Filled hole with mud from total depth to 300'.
Set plug--25 sacks cement to 223'.
Mud to 40'--set plug.
Cement to base of cellar--10 sacks.
2 sacks cement in rat hole.

RECEIVED
STATE CORPORATION COMMISSION
AUG 31 1965
8-31-65
CONSERVATION DIVISION
Wichita, Kansas

(If additional description is necessary, use BACK of this sheet)

Name of Plugging Contractor K & E Drilling, Inc.
Address 719 Union Center, Wichita, Kansas

STATE OF Kansas, COUNTY OF Sedgwick, ss.
Leo Ross (employee of owner) or (~~XXXXXXXXXX~~) of the above-described well, being first duly sworn on oath, says: That I have knowledge of the facts, statements, and matters herein contained and the log of the above-described well as filed and that the same are true and correct. So help me God.

(Signature) [Signature]
301 S. Market, Wichita, Kansas 67202
(Address)

SUBSCRIBED AND SWORN TO before me this 30th day of August, 19 65

My commission expires July 21, 1966
Frances Leslie Notary Public.

15-007-0076-0000
LARIO OIL & GAS COMPANY
Lenkner No. 1
Cen. SW/4 Sec. 35-33S-14W
Barber County, Kansas

Drilling Commenced: 8-13-65
Drilling Completed: 8-25-65
Drilling Contractor: K & E Drilling, Inc.
Total Depth 4863' Driller's.
4870' Electric Log.

<u>Formation</u>	<u>Depth</u>
Clay & gyp	140
Sand & shale	160
Shale	402
Red bed	1124
Shale & shells	1905
Lime & shale	2287
Lime	2845
Lime & shale	2970
Shale & lime	3235
Lime	4036
Lime & shale	4145
Lime	4863

Casing Record:

8 5/8" 396.87' Set @ 401'
Cem. w/ 400 sacks

Electric Log Tops:

Elgin	3859' (-2131')
Heebner	3995' (-2267')
Lansing	4178' (-2450')
Mississippian	4739' (-3011')
Elec. Log T.D.	4870' (-3142')

RECEIVED
STATE CORPORATION COMMISSION

AUG 31 1965
8-31-65
CONSERVATION DIVISION
Wichita, Kansas