


WELL PLUGGING RECORD

Give All Information Completely  
Make Required Affidavit  
Mail or Deliver Report to:  
Conservation Division  
State Corporation Commission  
211 No. Broadway  
Wichita, Kansas

Barber County. Sec. 36 Twp. 33 Rge. (E) 14 (W)  
Location as "NE/CNW/SW" or footage from lines. NE SE SW  
Lease Owner Skelly Oil Company  
Lease Name Fred G. Roth Well No. 1  
Office Address P. O. Box 649, McCook, Nebraska  
Character of Well (completed as Oil, Gas or Dry Hole) dry hole  
Date well completed 4-26-65 1965  
Application for plugging filed 4-26 1965  
Application for plugging approved 4-26 1965  
Plugging commenced 4-26 1965  
Plugging completed 4-26 1965  
Reason for abandonment of well or producing formation dry

NORTH

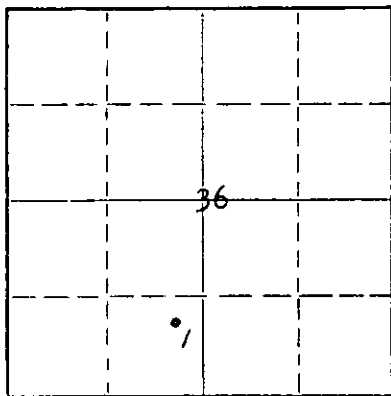

Locate well correctly on above  
Section Plat

If a producing well is abandoned, date of last production \_\_\_\_\_ 19\_\_\_\_  
Was permission obtained from the Conservation Division or its agents before plugging was commenced? Yes (verbally)

Name of Conservation Agent who supervised plugging of this well Mr. A. Elving  
Producing formation \_\_\_\_\_ Depth to top \_\_\_\_\_ Bottom \_\_\_\_\_ Total Depth of Well 5227 Feet  
Show depth and thickness of all water, oil and gas formations.

OIL, GAS OR WATER RECORDS

CASING RECORD

FORMATION	CONTENT	FROM	TO	SIZE	PUT IN	PULLED OUT
<u>Simpson Sand</u>	<u>Dry</u>	<u>5182</u>		<u>8-5/8</u>	<u>357</u>	<u>-0-</u>

Describe in detail the manner in which the well was plugged, indicating where the mud fluid was placed and the method or methods used in introducing it into the hole. If cement or other plugs were used, state the character of same and depth placed, from \_\_\_\_\_ feet to \_\_\_\_\_ feet for each plug set.

<u>Mud laden fluid</u>	<u>5227'</u>	<u>to</u>	<u>285'</u>
<u>Rock bridge</u>	<u>285'</u>	<u>to</u>	<u>275'</u>
<u>28 sacks cement</u>	<u>275'</u>	<u>to</u>	<u>191'</u>
<u>Mud laden fluid</u>	<u>191'</u>	<u>to</u>	<u>40'</u>
<u>Rock bridge</u>	<u>40'</u>	<u>to</u>	<u>30'</u>
<u>10 sacks cement</u>	<u>30'</u>	<u>to</u>	<u>Base of cellar</u>
<u>Surface soil</u>	<u>Cellar</u>	<u>to</u>	<u>Surface</u>

RECEIVED  
STATE CORPORATION COMMISSION

JUN 28 1965

6-28-65

CONSERVATION DIVISION  
Wichita, Kansas

(If additional description is necessary, use BACK of this sheet)

Name of Plugging Contractor K & E DRILLING, INC.  
Address 719 Union Center, Wichita, Kansas

STATE OF Nebraska, COUNTY OF Red Willow, ss.  
C. E. Bass (employee of owner) or (owner/operator) of the above-described well, being first duly sworn on oath, says: That I have knowledge of the facts, statements, and matters herein contained and the log of the above-described well as filed and that the same are true and correct. So help me God.

(Signature) C. E. Bass

P.O. BOX 649, McCook, Nebraska  
(Address)

SUBSCRIBED AND SWORN to before me this 25th day of June, 1965

My commission expires June 13, 1969

C. C. Lindsey  
C. C. Lindsey Notary Public.

# DRILLER'S WELL LOG

OPERATOR: SKELLY OIL COMPANY  
P. O. Box 649  
McCook, Nebraska

WELL NAME: No. 1 Fred G. Roth  
LOCATION: NE SE SW, 36-33S-14W  
Barber Co., Kansas

CONTRACTOR: **K & E DRILLING, INC.**  
719 UNION CENTER BLDG.  
WICHITA, KANSAS

COMMENCED: 4-9-65

CASING RECORD: 8-5/8" @ 357' w/200 sx.

COMPLETED: 4-26-65

ELEVATION:

ROTARY TOTAL DEPTH: 5227'

PRODUCTION: D & A

## FORMATION RECORD

Depths shown indicate bottom of formations encountered.

Shale	125
Sand	160
Shale & Shells	352
Shells	357
Shale & Shells	1975
Shale & Lime	2215
Lime	2600
Lime & Shale	3409
Lime	3995
Lime & Shale	4140
Lime	5188
Shale & Sand	5222
Lime	5227

K & E DRILLING

RECEIVED  
STATE CORPORATION COMMISSION

JUN 28 1965  
6-28-65  
CONSERVATION DIVISION  
Wichita, Kansas

## CERTIFICATION

State of KANSAS }  
County of SEDGWICK } ss:

I, H. L. Wilson, of K&E DRILLING, INC., upon oath state that the above and foregoing is a true and correct copy of the Driller's Log of the above named well.

Subscribed and sworn to before me this 6th day of May, 19 65

My Commission expires: 8-30-65  
Jalene M. Bannon Notary Public.



K & E DRILLING