

CARD MUST BE TYPED

State of Kansas

CARD MUST BE SIGNED

# NOTICE OF INTENTION TO DRILL

(see rules on reverse side)

✓ 0

Expected Spud Date..... 12 26 88  
month day year

API Number 15— 007-01,024-0001

OPERATOR: License # 3835 & 3504

SW SW SW Sec. 3 Twp. 34 S. Rg. 12  East  West

Name Cross Continent Res. Inc. & Spurlock & Spines

330 Ft. from South Line of Section

Address 155 N. Market #200 Expl., Inc.

4950 Ft. from East Line of Section

City/State/Zip Wichita, KS 67202

(Note: Locate well on Section Plat on reverse side)

Contact Person Thomas M. Williams

Nearest lease or unit boundary line 330 feet

Phone 262-5061

County Barber

CONTRACTOR: License # 5929

Lease Name Farney Well # 1-3

Name Duke Drilling Co., Inc.

Ground surface elevation 1475 feet MSL

City/State Wichita, KS

Domestic well within 330 feet:  yes  no

Well Drilled For: Well Class: Type Equipment:

Municipal well within one mile:  yes  no

Oil  Storage  Infield  Mud Rotary

Depth to bottom of fresh water 100

Gas  Inj  Pool Ext.  Air Rotary

Depth to bottom of usable water 180

OWWO  Expl  Wildcat  Cable

Surface pipe by Alternate: 1  2

If OWWO: old well info as follows:

Surface pipe ~~alternate~~ set 300 200

Operator Pickrell Drilling Company

Conductor pipe required

Well Name Hutchison #1

Projected Total Depth 5200 feet

Comp Date 10-18-56 Old Total Depth 4767

Formation Simpson

I certify that well will comply with K.S.A. 55-101, et seq., plus eventually plugging hole to KCC specifications

Date 12-15-88 Signature of Operator or Agent

*Bradley D. Buckner - President*

For KCC Use:

Conductor Pipe Required \_\_\_\_\_ feet; Minimum Surface Pipe Required \_\_\_\_\_ feet per Alt. 1

This Authorization Expires 6-16-89

Approved By LKM 12-16-89


EFFECTIVE DATE: 12-21-88

Must be filed with the K.C.C. five (5) days prior to commencing well  
This card void if drilling not started within six (6) months of date received by K.C.C.

**Important procedures to follow:**

1. Notify District office before setting surface casing.
2. Set surface casing by circulating cement to the top.
3. File completion forms ACO-1 with K.C.C. within 120 days of well spud date, following instructions on ACO-1, side 1, and including copies of wireline logs.
4. Notify District office 48 hours prior to old well workover or re-entry.
5. Prior to filing Intent, prepare a proposed plugging plan in case well is D & A, then obtain approval of plan when calling district office prior to setting surface pipe.
6. Submit plugging report (CP-4) to K.C.C. after plugging is completed.
7. Obtain an approved injection docket number before disposing of salt water.
8. Notify K.C.C. within 10 days when injection commences or terminates.
9. If an alternate 2 completion, cement in the production pipe from the bottom of the well to prevent any usable water to surface within 120 days of spud date.

**A Regular Section of Land  
1 Mile = 5,280 Ft.**

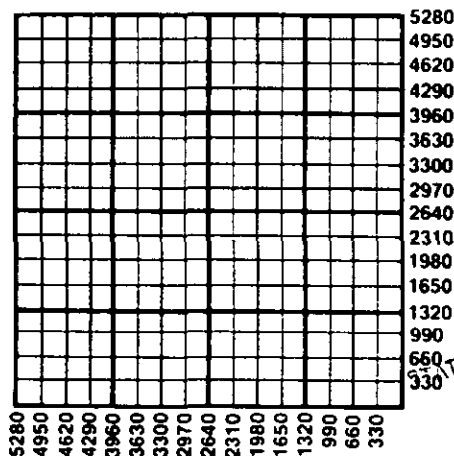

RECEIVED  
OCT 15 1988  
STATE CORPORATION COMMISSION  
12-16-88  
LUC  
CONSERVATION DIVISION  
Wichita, Kansas

State Corporation Commission of Kansas  
Conservation Division  
200 Colorado Derby Building  
Wichita, Kansas 67202-1212  
(316) 263-3238