

EFFECTIVE DATE: 5-20-91

NOTICE OF INTENTION TO DRILL

Must be approved by the K.C.C. five (5) days prior to commencing well

Expected Spud Date 5.....29.....91.....
month day year

NE SW NW 34. Twp 16. S, Rg 24. X East West ✓

.....3630..... feet from South line of Section ✓
.....4290..... feet from East line of Section ✓

(Note: Locate well on Section Plat on Reverse Side)

OPERATOR: License # 7076 ✓
Name: Black Diamond Oil, Inc. ✓
Address: 3004 Broadway Ave
City/State/Zip: Hays, Ks, 67601
Contact Person: Kenneth Vehige
Phone: 913 625-5891

County: Ness ✓
Lease Name: Wisehart Well #: 1 ✓
Field Name: Ransom ✓

CONTRACTOR: License #: 8241 ✓
Name: Emphasis Oil Operations

Is this a Prorated Field? yes X.. no ✓
Target Formation(s): Mississippi ✓
Nearest lease or unit boundary: 990 ✓

Well Drilled For: Well Class: Type Equipment:
XOil ... Inj XInfield XMud Rotary ✓
... Gas ... Storage ... Pool Ext. ... Air Rotary
... OWWO ... Disposal ... Wildcat ... Cable
... Seismic; ... # of Holes

Ground Surface Elevation:N/A..... feet MSL ✓
Domestic well within 330 feet: yes X.. no ✓
Municipal well within one mile: yes X.. no ✓

If OWWO: old well information as follows:
Operator:
Well Name:
Comp. Date: Old Total Depth

Depth to bottom of fresh water:150!..... ✓
Depth to bottom of usable water:1000!..... ✓
Surface Pipe by Alternate: 1 X 2 ✓

Directional, Deviated or Horizontal wellbore? yes X no ✓
If yes, total depth location:

Length of Surface Pipe Planned to be set: 200!..... ✓
Length of Conductor pipe required: 200!..... ✓
Projected Total Depth: 4500!..... ✓
Formation at Total Depth: Mississippi ✓

Water Source for Drilling Operations:
... well X farm pond other ✓

DWR Permit #:
Will Cores Be Taken?: yes X.. no ✓
If yes, proposed zone:

AFFIDAVIT

The undersigned hereby affirms that the drilling, completion and eventual plugging of this well will comply with K.S.A. 55-101, et. seq.

It is agreed that the following minimum requirements will be met:

1. The appropriate district office shall be notified before setting surface pipe;
2. The minimum amount of surface pipe as specified above shall be set by circulating cement to the top; in all cases surface pipe shall be set through all unconsolidated materials plus a minimum of 20 feet into the underlying formation;
3. If the well is dry, a plugging proposal shall be submitted to the district office. An agreement between the operator and the district office on plug length and placement is necessary prior to plugging;
4. The appropriate district office will be notified before well is either plugged or production casing is cemented in;
5. If an Alternate II completion, production pipe shall be cemented from below any usable water to surface within 120 days of spud date. In all cases, notify district office prior to any cementing.

I hereby certify that the statements made herein are true and to the best of my knowledge and belief.

Date: 5/9/91. Signature of Operator or Agent: Kenneth Vehige Title: Owner/Operator.

FOR KCC USE:

API # 15- 135-23576-00-00
 Conductor pipe required None feet
 Minimum surface pipe required 200 feet per Alt. (2)
 Approved by: MDW 5-15-91
 EFFECTIVE DATE: 5-20-91
 This authorization expires: 11-15-91
 (This authorization void if drilling not started within 6 months of effective date.)
 Spud date: _____ Agent: _____

RECEIVED
STATE CORPORATION COMMISSION

MAY 15 1991

CONSERVATION DIVISION
Wichita, Kansas

REMEMBER TO:

- File Drill Pit Application (form CDP-1) with Intent to Drill;
- File Completion Form ACO-1 within 120 days of spud date;
- File acreage attribution plat according to field prorated orders;
- Notify appropriate district office 48 hours prior to workover or re-entry;
- Submit plugging report (CP-4) after plugging is completed;
- Obtain written approval before disposing or injecting salt water.

34
16
24W


PLAT OF ACREAGE ATTRIBUTABLE TO A WELL

State Corporation Commission, Conservation Division
200 Colorado Derby Bldg. Wichita, Kansas 67202

OPERATOR Black Diamond Oil, Inc. LOCATION OF WELL:
 LEASE Wisehart 3630 feet north of SE corner
 WELL NUMBER 1 4290 feet west of SE corner
 FIELD Ransom NW/4 Sec. 34 T 16 R 24 ~~XX~~W
 COUNTY Ness
 NO. OF ACRES ATTRIBUTABLE TO WELL 10 IS SECTION X REGULAR IRREGULAR?
 IF IRREGULAR, LOCATE WELL FROM NEAREST
 DESCRIPTION OF ACREAGE NW/4 CORNER BOUNDARY.

NOTE: If plat depicted is insufficient for your circumstances, you may attach your own scaled or surveyed plat.

PLAT

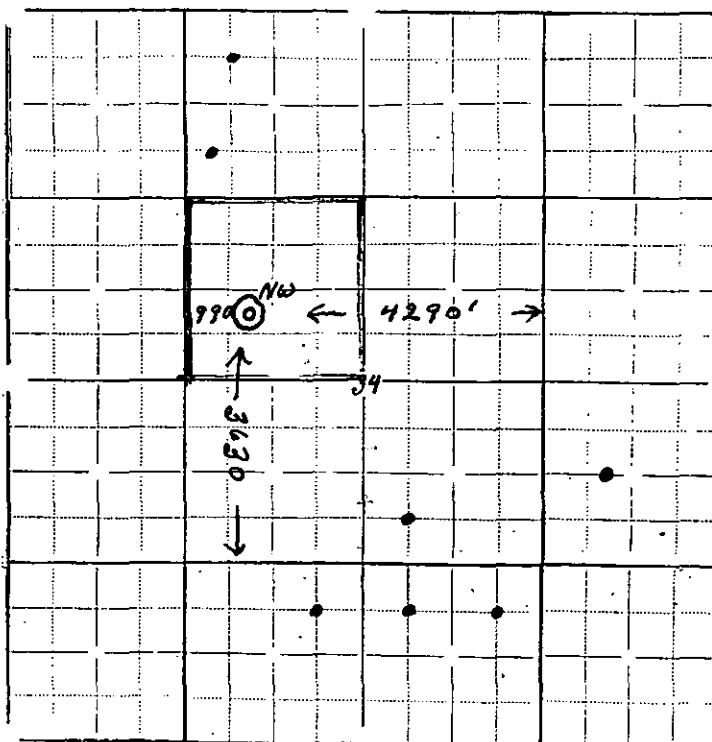

In plotting the proposed location of the well, you must show:

- 1) The manner in which you are using the depicted plat by identifying section lines, i.e. 1 section (1 section with 8 surrounding partial sections) 4 sections, 16 sections, etc.;
- 2) the well's location relative to the location of other wells producing from the same common source of supply in adjoining drilling units, pursuant to K.A.R. 82-3-108, 82-3-207, 82-3-312, or special orders of the Commission;
- 3) the distance of the proposed drilling location from the section's east and south lines; and
- 4) the distance to the nearest lease or unit boundary line. 990'

I hereby certify that the statements made herein are true and to the best of my knowledge and belief.

Signature of Operator or Agent [Signature]
 Date 5/9/91 Title Owner/Operator