

FOR KCC USE:

**XCORRECTION II**

**CR**

FORM C-1 7/91

FORM MUST BE TYPED

FORM MUST BE SIGNED

ALL BLANKS MUST BE FILLED

EFFECTIVE DATE: 5-24-94

8/15/94 \* Correction

DISTRICT # 17  
SGA? ... Yes ... No

State of Kansas  
NOTICE OF INTENTION TO DRILL

Must be approved by the K.C.C. five (5) days prior to commencing well

Expected Spud Date ... July ... 25 ... 1994 ...  
month day year

Spot \_\_\_\_\_ East  
\* .NW.- ..SE.- ..NW. Sec ..16. Twp ..33. S, Rg ..14. X West

OPERATOR: License # ... 5447 ...  
Name: ..... OXY USA INC. ....  
Address: ..... 110 S. Main #800. ....  
City/State/Zip: ... Wichita, Kansas. 67202. ....  
Contact Person: ... Carla Davis. ....  
Phone: .... (316) 265-5624. ....

\* ..... 3355 ..... feet from South - North line of Section  
\* ..... 3355 ..... feet from East West line of Section  
IS SECTION X REGULAR \_\_\_\_\_ IRREGULAR?

(NOTE: Locate well on the Section Plat on Reverse Side)

County: ..... Barber. ....  
Lease Name: ..... McGrath "A" ..... Well #: ... 1. ....  
Field Name: ..... Aetna. ....

Is this a Prorated/Spaced Field? .... yes ..X. no  
Target Formation(s): ... Mississippi. ....

CONTRACTOR: License #: .....  
Name: .... (Unknown at this time) .....

\* Nearest lease or unit boundary: ... \* .. 1925' .....  
\* Ground Surface Elevation: .... \* ... 1726 ..... feet MSL

Well Drilled For: Well Class: Type Equipment:  
... Oil ... Enh Rec ... Infield .X. Mud Rotary  
.X. Gas ... Storage .X. Pool Ext. ... Air Rotary  
.X. OWWO ... Disposal ... Wildcat ... Cable  
... Seismic; ... # of Holes ... Other  
... Other .....

Water well within one-quarter mile: .... yes ..X. no  
Public water supply well within one mile: .... yes ..X. no

Depth to bottom of fresh water: ..... 80' .....  
Depth to bottom of usable water: ..... 180' .....

If OWWO: old well information as follows:

Surface Pipe by Alternate: ..X. 1 .... 2  
\* Length of Surface Pipe ~~Planned to be set:~~ 812' (Existing).  
Length of Conductor pipe required: .....

Operator: .. Jones-Gebert Oil Company. ....  
Well Name: .. McGrath #1. ....  
\* Comp. Date: ... 5/21/63. .... Old Total Depth \* .. 4751' .....

\* Projected Total Depth: ..... 4990' .....  
\* Formation at Total Depth: ..... Viola. ....

Directional, Deviated or Horizontal wellbore? .... yes ..X. no

Water Source for Drilling Operations:  
... well .... farm pond ..X. other

If yes, true vertical depth: .....

DWR Permit #: .....  
Will Cores Be Taken?: .... yes ..X. no

Bottom Hole Location: .....

If yes, proposed zone: .....

**WAS: NW-NW-NE; SEE additional changes MARKED**  
**AFFIDAVIT**

RECEIVED  
STATE CORPORATION COMMISSION

The undersigned hereby affirms that the drilling, completion and eventual plugging of this well will comply with K.S.A. 55-101, et. seq.

AUG 10 1994

It is agreed that the following minimum requirements will be met:

8-10-94

1. Notify the appropriate district office prior to spudding of well;
2. A copy of the approved notice of intent to drill shall be posted on each drilling rig
3. The minimum amount of surface pipe as specified below shall be set by circulating cement to the top of the surface pipe shall be set through all unconsolidated materials plus a minimum of 20 feet into the underlying formation;
4. If the well is dry hole, an agreement between the operator and the district office on plug length and placement is necessary prior to plugging;
5. The appropriate district office will be notified before well is either plugged or production casing is cemented in;
6. IF AN ALTERNATE II COMPLETION, PRODUCTION PIPE SHALL BE CEMENTED FROM BELOW ANY USABLE WATER TO SURFACE WITHIN 120 DAYS OF SPUD DATE. IN ALL CASES, NOTIFY DISTRICT OFFICE PRIOR TO ANY CEMENTING.

CONSERVATION DIVISION

I hereby certify that the statements made herein are true and to the best of my knowledge and belief.

Date: ..... 8-8-94 ..... Signature of Operator or Agent: .. Carla Davis. .... Title: ... Engineering Aide. ....

15-007-01042-00-01

**XCORRECTION II**  
**ORIG. A.P.I. REPORTED**  
**AS 15-007-01042**  
**ON CORRECTION DATED**  
**8-10-94 WAS RAN**  
**AS 15-007-01040**

FOR KCC USE: 01042 (8/15/94) CB  
 API # 15- 007-01040  
 Conductor pipe required NONE feet  
 Minimum surface pipe required 812' feet per Alt. (1) X  
 Approved by: DW 8-10-94/CRS-1994  
 This authorization expires: 11-19-94  
 (This authorization void if drilling not started within 6 months of effective date.)  
 Spud date: \_\_\_\_\_ Agent: \_\_\_\_\_

REMEMBER TO:

- File Drill Pit Application (form CDP-1) with Intent to Drill;
- File Completion Form ACO-1 within 120 days of spud date;
- File acreage attribution plat according to field proration orders;
- Notify appropriate district office 48 hours prior to workover or re-entry;
- Submit plugging report (CP-4) after plugging is completed;
- Obtain written approval before disposing or injecting salt water.

Mail to: Conservation Division, 200 Colorado Derby Building, 202 W. First St., Wichita, Kansas 67202-1286.

10  
33  
14

**IS 15-007 01042**  
**8/15/94 CB**

**IN ALL CASES PLOT THE INTENDED WELL ON THE PLAT BELOW**

**PLAT OF ACREAGE ATTRIBUTABLE TO A WELL IN A PRORATED OR SPACED FIELD**

If the intended well is in a prorated or spaced field, please fully complete this side of the form. If the intended well is in a prorated or spaced field complete the plat below showing that the well will be properly located in relationship to other wells producing from the common source of supply. Please show all the wells within 1 mile of the boundaries of the proposed acreage attribution unit for gas wells and within 1/2 mile of the boundaries of the proposed acreage attribution unit for oil wells.

API NO. 15- \_\_\_\_\_  
 OPERATOR OXY USA INC.  
 LEASE McGrath "A"  
 WELL NUMBER 1  
 FIELD Aetna



LOCATION OF WELL: COUNTY Barber  
3355 feet from south/~~north~~ line of section  
3355 feet from east/~~west~~ line of section  
 SECTION 16 TWP 33S RG 14W

NUMBER OF ACRES ATTRIBUTABLE TO WELL \_\_\_\_\_  
 QTR/QTR/QTR OF ACREAGE NW - SE - NW

IS SECTION X REGULAR or \_\_\_\_\_ IRREGULAR  
**IF SECTION IS IRREGULAR, LOCATE WELL FROM NEAREST CORNER BOUNDARY.**  
 Section corner used: \_\_\_\_\_ NE \_\_\_\_\_ NW \_\_\_\_\_ SE \_\_\_\_\_ SW

**PLAT**

(Show location of the well and shade attributable acreage for prorated or spaced wells.)  
 (Show footage to the nearest lease or unit boundary line.)

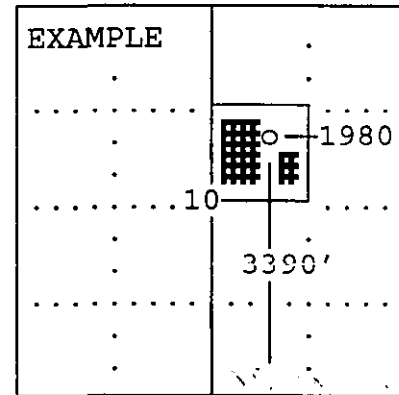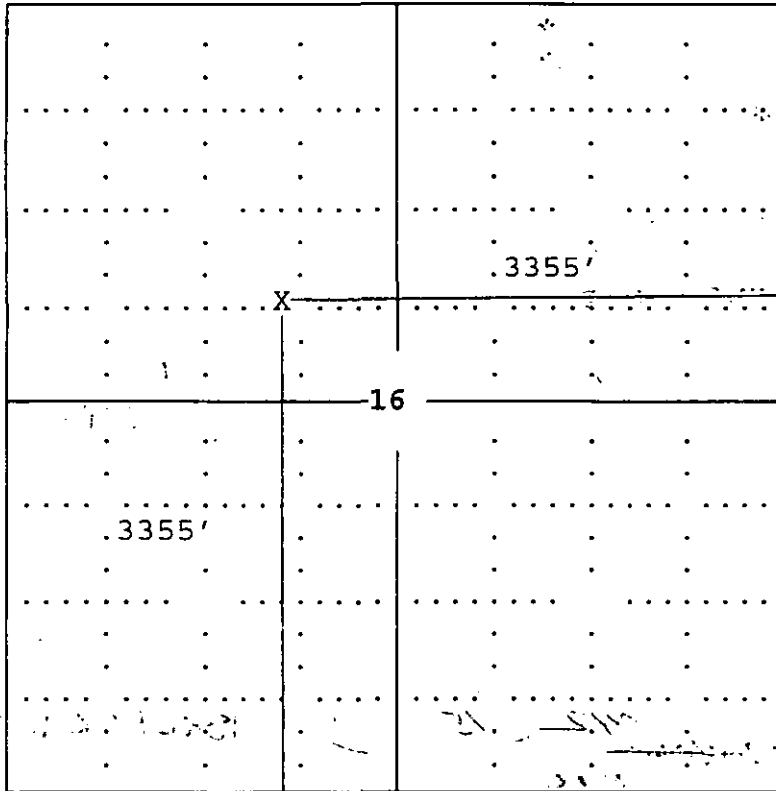

SEWARD CO.

**BARBER County**

In plotting the proposed location of the well, you must show:

- 1) The manner in which you are using the depicted plat by identifying section lines, i.e. 1 section, 1 section with 8 surrounding sections, 4 sections, etc.;
- 2) the distance of the proposed drilling location from the section's south/north and east/west; and
- 3) the distance to the nearest lease or unit boundary line.