


PLAT OF ACREAGE ATTRIBUTABLE TO A WELL

State Corporation Commission, Conservation Division
200 Colorado Derby Bldg. Wichita, Kansas 67202

OPERATOR <u>TXO PRODUCTION CORPORATION</u>	LOCATION OF WELL:
LEASE <u>Wheat "A"</u>	<u>3960</u> feet north of SE corner
WELL NUMBER <u>2</u>	<u>3970</u> feet west of SE corner
FIELD <u>Aetna</u>	<u>NW/4</u> Sec. <u>34</u> T <u>33S</u> R <u>14</u> E/W
	COUNTY <u>Barber</u>
NO. OF ACRES ATTRIBUTABLE TO WELL <u>160</u>	IS SECTION <u> </u> REGULAR <u> </u> IRREGULAR?
DESCRIPTION OF ACREAGE <u>NW/4</u>	IF IRREGULAR, LOCATE WELL FROM NEAREST CORNER BOUNDARY.

NOTE: If plat depicted is insufficient for your circumstances, you may attach your own scaled or surveyed plat.

PLAT

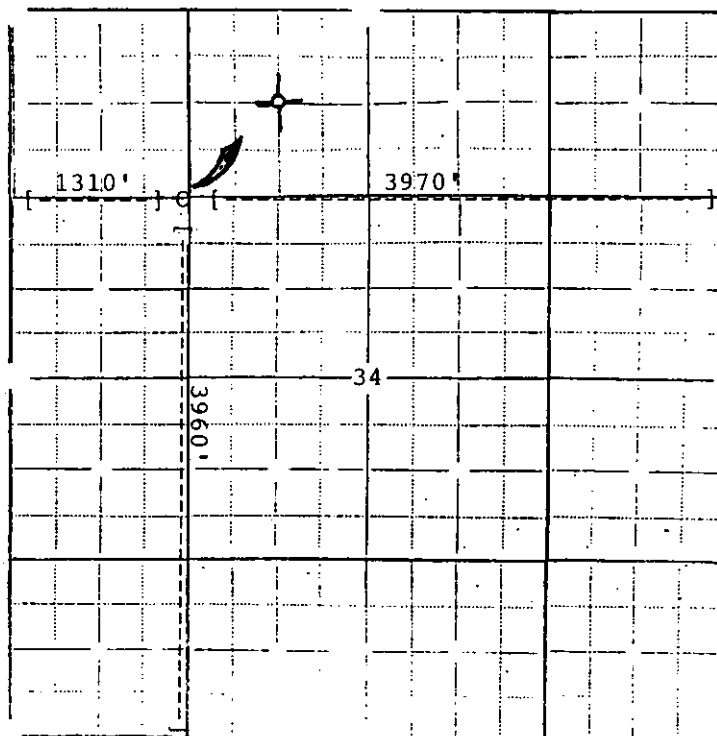

In plotting the proposed location of the well, you must show:

- 1) The manner in which you are using the depicted plat by identifying section lines, i.e. 1 section, 1 section with 8 surrounding partial sections, 4 sections, 16 sections, etc.;
- 2) the well's location relative to the location of other wells producing from the same common source of supply in adjoining drilling units, pursuant to K.A.R. 82-3-108, 82-3-207, 82-3-312, or special orders of the Commission;
- 3) the distance of the proposed drilling location from the section's east and south lines; and
- 4) the distance to the nearest lease or unit boundary line.

I hereby certify that the statements made herein are true and to the best of my knowledge and belief.

Signature of Operator or Agent James B. Phillips
 Date 7/13/90 Title Agent