

CARD MUST BE TYPED

State of Kansas
NOTICE OF INTENTION TO DRILL
 (see rules on reverse side)

CARD MUST BE SIGNED

Starting Date: February 18, 1985
 month day year

OPERATOR: License # 5360
 Name Brandt Production Co., Inc.
 Address 105 S. Broadway
 City/State/Zip Wichita, Kansas 67202
 Contact Person Earl O. Brandt
 Phone 316-267-4335

CONTRACTOR: License # 5840
 Name Brandt Drilling Co., Inc.
 City/State Wichita, Kansas

Well Drilled For:	Well Class:	Type Equipment:
☒ Oil ☐ Swd ☐ Infield ☒ Mud Rotary		
☐ Gas ☐ Inj ☐ Pool Ext. ☐ Air Rotary		
☐ OWWO ☐ Expl ☒ Wildcat ☐ Cable		

If OWWO: old well info as follows:

Operator
 Well Name
 Comp Date Old Total Depth
 Projected Total Depth 5150 feet
 Projected Formation at TD Simpson
 Expected Producing Formations Miss-Simpson

I certify that we will comply with K.S.A. 55-101, et seq., plus eventually plugging hole to K.C.C. specifications.

Date 1-17-85 Signature of Operator or Agent

API Number 15- 007-22, 011-00-00

NE NE SW Sec 14 Twp 34 S, Rge 10 ☐ East
 (location) ☒ West

2310 Ft North from Southeast Corner of Section

2970 Ft West from Southeast Corner of Section
 (Note: Locate well on Section Plat on reverse side)

Nearest lease or unit boundary line 330 feet.

County Barber

Lease Name Swartz Well# 1

Domestic well within 330 feet: ☐ yes ☒ no

Municipal well within one mile: ☐ yes ☒ no

Depth to Bottom of fresh water 100 Nippelowalle feet

Lowest usable water formation Harper Siltstone Grp

Depth to Bottom of usable water 180 200 feet

Surface pipe by Alternate: 1 ☒ 2 ☐

Surface pipe to be set 240 feet

Conductor pipe if any required none feet

Ground surface elevation 1310 feet MSL

This Authorization Expires 8-20-85

Approved By 2-20-85

President


Form C-1 4/84

MHC/UDHE 2-20-85

Must be filed with the K.C.C. five (5) days prior to commencing well
This card void if drilling not started within six (6) months of date received by K.C.C.

Important procedures to follow :

**A Regular Section of Land
1 Mile = 5,280 Ft.**

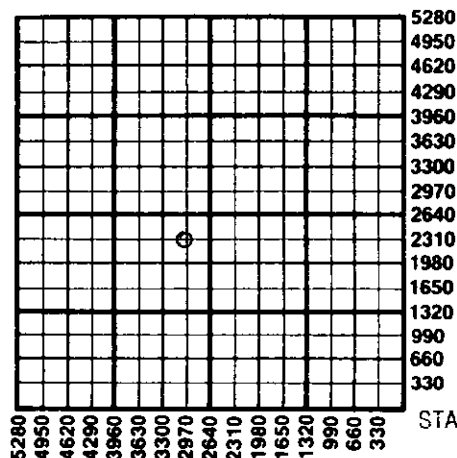

1. Notify District office before setting surface casing.
2. Set surface casing by circulating cement to the top.
3. File completion forms ACO-1 with K.C.C. within 90 days of well completion, following instructions on ACO-1, side 1, and including copies of wireline logs.
4. Notify District office 48 hours prior to old well workover or re-entry.
5. Prior to plugging, prepare a plugging plan, then obtain agreement from the appropriate district office for an approved plugging plan.
6. Submit plugging report (CP-4) to K.C.C. after plugging is completed.
7. Obtain an approved injection docket number before disposing of salt water.
8. Notify K.C.C. within 10 days when injection commences or terminates.
9. If an alternate 2 completion, cement in the production pipe from below any seepage water to surface within 120 days of spud date.

RECEIVED

STATE CORPORATION COMMISSION

FEB 20 1985
02-20-1985
CONSERVATION DIVISION
Wichita, Kansas

State Corporation Commission of Kansas
Conservation Division
200 Colorado Derby Building
Wichita, Kansas 67202
(316) 263-3238