

CARD MUST BE SIGNED

Starting Date:September..17,..1984.....
month day year

OPERATOR: License # 6006

NameMolz Oil Company.....

Address R.R. #2, Box 54

City/State/Zip Kiowa, Kansas 67070

Contact Person Jim Molz

Phone 316-296-4558

CONTRACTOR: License # 5658

NameSweetman Drilling, Inc.....

City/State Wichita, Kansas 67202

Well Drilled For: Well Class: Type Equipment:

☒ On ☐ Swd ☐ Infield ☒ Mud Rotary

☒ Gas ☐ Inj ☒ Pool Ext. ☐ Air Rotary

☐ OWWO ☐ Expl ☐ Wildcat ☐ Cable

If QWWO: old well info as follows:

Operator

Well Name

Comp Date **Old Total Depth**

Projected Total Depth4900..... feet

Projected Formation at TD...Mississippi.....

Expected Producing FormationsMississippi.....

API Number 15- 001-21, 881-0000

625 FSL ☐ East650 FWL Sec 13 Ten 35 S. Reg. 12 ☐ West


.....625..... Ft North from Southeast Corner of Section

....4630..... Ft West from Southeast Corner of Section

(Note: Locate well on Section Plat on reverse side)

Nearest lease or unit boundary line625..... feet.

County Barber.....

Lease Name ...Yates.C..... Well# ..2.....

Domestic well within 330 feet: ☐ yes ☒ no

Municipal well within one mile : ☐ yes ☒ no

Depth to Bottom of fresh water1.00..... feet

Lowest usable water formation Permian

Depth to Bottom of usable water 200 feet

Surface pipe by Alternate : 1 ☒ 2 ☐

Surface pipe to be set 240 feet

Conductor pipe if any required none feet

Ground surface elevation 1341 feet MSL.

This Authorization Expires 2-16-85.....

Approved By RLH/KCC 7-16-84

I certify that we will comply with K.S.A. 55-101, et seq., plus eventually plugging hole to K.C.C. specifications

Date 7-12-84.... Signature of Operator or Agent

Title ..President.....


Form C-1 4/84


Must be filed with the K.C.C. five (5) days prior to commencing well
This card void if drilling not started within six (6) months of date received by K.C.C.

Important procedures to follow:

**A Regular Section of Land
1 Mile = 5,280 Ft.**

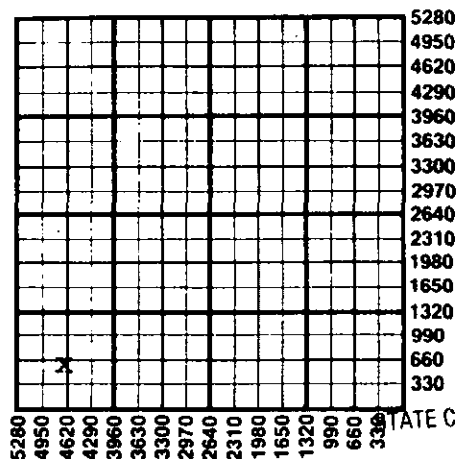

1. Notify District office before setting surface casing.
2. Set surface casing by circulating cement to the top.
3. File completion forms ACO-1 with K.C.C. within 90 days of well completion, following instructions on ACO-1, side 1, and including copies of wireline logs.
4. Notify District office 48 hours prior to old well workover or re-entry.
5. Prior to plugging, prepare a plugging plan, then obtain agreement from the appropriate district office for an approved plugging plan.
6. Submit plugging report (CP-4) to K.C.C. after plugging is completed.
7. Obtain an approved injection docket number before disposing of salt water.
8. Notify K.C.C. within 10 days when injection commences or terminates.

As an alternate 2 completion, cement in the production pipe from below any underflow water to surface within 120 days of spud date.

RECEIVED
JUL 16 1984
7-16-84
CONSERVATION DIVISION
Wichita, Kansas

State Corporation Commission of Kansas
Conservation Division
200 Colorado Derby Building
Wichita, Kansas 67202
(316) 263-3238