

EFFECTIVE DATE: 8-18-90

FORM MUST BE TYPED
FORM C-1 4/90

State of Kansas
NOTICE OF INTENTION TO DRILL

FORM MUST BE SIGNED
ALL BLANKS MUST BE FILLED

Must be approved by the K.C.C. five (5) days prior to commencing well

Expected Spud Date August 13, 1990
month day year

APR 90'S & 180'E of
... N/2 NW. Sec 17 Twp 31 S, Rg 17 X East West ✓
4530 feet from South line of Section ✓
3780 feet from East line of Section ✓
(Note: Locate well on Section Plat on Reverse Side)

OPERATOR: License # 5178 ✓
Name: SIDWELL OIL & GAS, INC.
Address: P. O. Box 2475
City/State/Zip: Pampa, Texas 79065
Contact Person: Cliff Sanders
Phone: 806/669-3383

County: Comanche ✓
Lease Name: Huff Well #: 3-17 ✓
Field Name: UNKNOWN ✓

CONTRACTOR: License #: 5929 ✓
Name: DUKE DRILLING CO., INC.

Is this a Prorated Field? ... yes X no ✓
Target formation(s): Miss. ✓
Nearest lease or unit boundary: 750' ✓
Ground Surface Elevation: 2132' feet MSU ✓

Well Drilled For: Well Class: Type Equipment:
Oil ... Inj ... X Infield ... X Mud Rotary ✓
X Gas ... Storage ... Pool Ext. ... Air Rotary
... OAWO ... Disposal ... Wildcat ... Cable
... Seismic; ... # of Holes

Domestic well within 330 feet: ... yes X no ✓
Municipal well within one mile: ... yes X no ✓
Depth to bottom of fresh water: 200' 180' ✓
Depth to bottom of usable water: 200' 240' ✓
Surface Pipe by Alternate: X 1 ... 2 ✓
Length of Surface Pipe Planned to be set: 600' ✓
Length of Conductor pipe required: N/A ✓

If OAWO: old well information as follows:
Operator: _____
Well Name: _____
Comp. Date: _____ Old Total Depth _____

Projected Total Depth: 5200' ✓
Formation at Total Depth: Mississippi ✓
Water Source for Drilling Operations:
... well ... farm pond X other ✓

Directional, Deviated or Horizontal wellbore? ... yes X no ✓
If yes, total depth location: _____

DWR Permit #: _____
Will Cores Be Taken?: ... yes X no ✓
If yes, proposed zone: _____

AFFIDAVIT

The undersigned hereby affirms that the drilling, completion and eventual plugging of this well will comply with K.S.A. 55-101, et. seq.

It is agreed that the following minimum requirements will be met:

1. The appropriate district office shall be notified before setting surface pipe;
2. The minimum amount of surface pipe as specified above shall be set by circulating cement to the top; in all cases surface pipe shall be set through all unconsolidated materials plus a minimum of 20 feet into the underlying formation;
3. If the well is dry, a plugging proposal shall be submitted to the district office. An agreement between the operator and the district office on plug length and placement is necessary prior to plugging;
4. The appropriate district office will be notified before well is either plugged or production casing is cemented in;
5. If an Alternate II completion, production pipe shall be cemented from below any usable water to surface within 120 days of spud date. In all cases, notify district office prior to any cementing.

I hereby certify that the statements made herein are true and to the best of my knowledge and belief.

Date: 8/6/90 Signature of Operator or Agent: James B. Phillips Title: _____ Agent: _____

FOR KCC USE:

API # 15- 033-20,790-00-00
 Conductor pipe required NONE feet
 Minimum surface pipe required 360 feet per Alt. ① 2
 Approved by: NRW 8-13-90
 EFFECTIVE DATE: 8-18-90
 This authorization expires: 2-13-91
 (This authorization void if drilling not started within 6 months of effective date.)
 Spud date: _____ Agent: _____

RECEIVED
DATE CONSERVATION DIVISION
AUG 7 1990
CONSERVATION DIVISION
Wichita, Kansas

CONTACT DISTRICT OFFICE PRIOR TO SPUDDING FOR APPROVAL

KCC OFFICE USE ONLY

WNRW 8-13-90
CT 4:30 PM CT

WAKA
8/7
KN

12
31
1200


PLAT OF ACREAGE ATTRIBUTABLE TO A WELL

State Corporation Commission, Conservation Division
200 Colorado Derby Bldg. Wichita, Kansas 67202

OPERATOR SIDWELL OIL & GAS, INC. LOCATION OF WELL:
 LEASE HUFF 4530 feet north of SE corner
 WELL NUMBER 3-17 3780 feet west of SE corner
 FIELD Unknown NW/4 Sec. 17 T 31S R 17 ~~EW~~
 COUNTY Comanche
 NO. OF ACRES ATTRIBUTABLE TO WELL 10 IS SECTION X REGULAR IRREGULAR?
 DESCRIPTION OF ACREAGE NW/4 IF IRREGULAR, LOCATE WELL FROM NEAREST
 CORNER BOUNDARY.

NOTE: If plat depicted is insufficient for your circumstances, you may attach your own scaled or surveyed plat.

PLAT

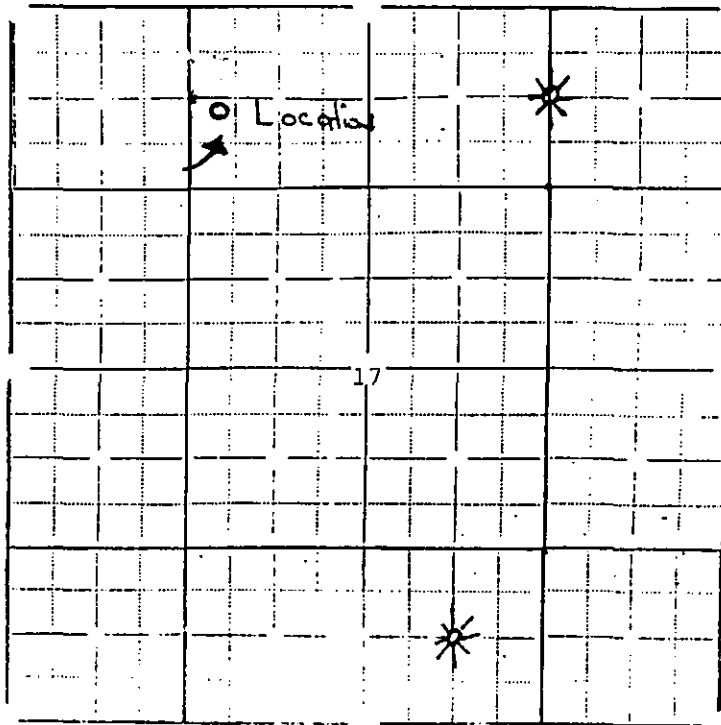

In plotting the proposed location of the well, you must show:

- 1) The manner in which you are using the depicted plat by identifying section lines, i.e. 1 section, 4 sections, 16 sections, etc.;
- 2) the well's location relative to the location of other wells producing from the same common source of supply in adjoining drilling units pursuant to K.A.R. 82-3-108, 82-3-207, 82-3-312, or special orders of the Commission;
- 3) the distance of the proposed drilling location from the section's east and south lines; and

the distance to the nearest lease or unit boundary line.

I hereby certify that the statements made herein are true and to the best of my knowledge and belief.

Signature of Operator or Agent James S. [Signature]
 Title Agent

Date August 6, 1990

KCC OFFICE USE ONLY

_____ W
 _____ CT