

NOTICE OF INTENTION TO DRILL

(see rules on reverse side)

Starting Date March 28 1986 month day year

API Number 15- 033-20,696-00-00

OPERATOR: License # 8362

C. NW SW Sec. 15 Twp. 31 S, Rg. 17 East X West

Name Held By Production, Inc.

1980 Ft. from South Line of Section

Address 6021 S. Syracuse Way #201

4620 Ft. from East Line of Section

City/State/Zip Englewood, CO 80111

(Note: Locate well on Section Plat on reverse side)

Contact Person Bob Einhorn

Phone (303) 694-4320

CONTRACTOR: License # 5829

Nearest lease or unit boundary line feet

Name Aldebaran Drilling Co., Inc.

County Comanche

City/State Wichita, KS 67218

Lease Name Ferrin Well # 1

Well Drilled For: Well Class: Type Equipment:

Ground surface elevation 2095 est. feet MSL

- Oil SWD Infield Mud Rotary
Gas Inj Pool Ext Air Rotary
OWWO Expl Wildcat Cable

Domestic well within 330 feet: yes X no

Municipal well within one mile: yes X no

Surface pipe by Alternate: 1 4 2

Depth to bottom of fresh water 200

Depth to bottom of usable water 200

Surface pipe planned to be set 600

Projected Total Depth 5400 feet

Formation Mississippi

If OWWO: old well info as follows:

Operator

Well Name

Comp Date Old Total Depth

I certify that well will comply with K.S.A. 55-101, et seq., plus eventually plugging hole to KCC specifications.

cementing will be done immediately upon setting production casing.

Date Signature of Operator or Agent Michael W. Kirkman Title Prod. Superintendent

For KCC Use:

Conductor Pipe Required 7-26-86 feet: Minimum Surface Pipe Required 100 feet per Alt 1 4


This Authorization Expires 3-26-86 Approved By

Must be filed with the K.C.C. five (5) days prior to commencing well
This card void if drilling not started within six (6) months of date received by K.C.C.

Important procedures to follow:

1. Notify District office before setting surface casing.
2. Set surface casing by circulating cement to the top.
3. File completion forms ACO-1 with K.C.C. within 90 days of well completion, following instructions on ACO-1, side 1, and including copies of wireline logs.
4. Notify District office 48 hours prior to old well workover or re-entry.
5. Prior to filing Intent, prepare a proposed plugging plan in case well is D & A, then obtain approval of plan when calling district office prior to setting surface pipe.
6. Submit plugging report (CP-4) to K.C.C. after plugging is completed.
7. Obtain an approved injection docket number before disposing of salt water.
8. Notify K.C.C. within 10 days when injection commences or terminates.

**A Regular Section of Land
1 Mile = 5,280 Ft.**

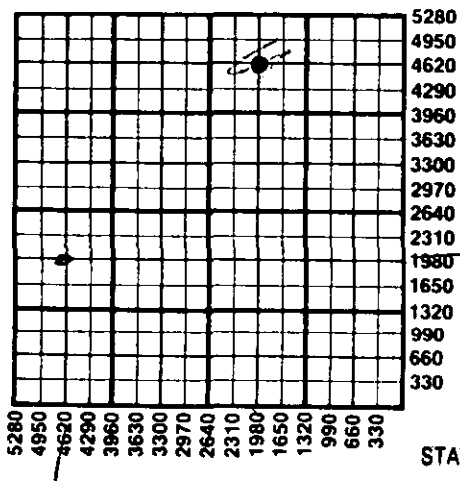

RECEIVED
STATE CORPORATION COMMISSION

MAR 26 1986

CONSERVATION DIVISION
Wichita, Kansas

If an alternate 2 completion, cement in the production pipe from below any usable water to surface within 120 days of spud date.

State Corporation Commission of Kansas
Conservation Division
200 Colorado Derby Building
Wichita, Kansas 67202
(316) 263-3238