

NOTICE OF INTENTION TO DRILL

(see rules on reverse side)

Starting Date December 1, 1985
month day year

API Number 15- 033-20,693-00-00

OPERATOR: License # 8362

^{W/2}
~~NW~~ NW NW Sec. 15 Twp. 31 S, Rg. 17 X East West
4620 Ft. from South Line of Section
4813 Ft. from East Line of Section

(Note: Locate well on Section Plat on reverse side)

Name Held By Production, Inc.

Address 6021 S. Syracuse Way, Suite 201

City/State/Zip Englewood, Colorado 80111

Contact Person R. B. Einhorn

Phone (303) 694-4335

Nearest lease or unit boundary line 467 feet

CONTRACTOR: License # 5829

County Comanche

Name Aldebaran Drilling Co., Inc.

Lease Name Yost Well # 2

City/State Wichita, Kansas

Ground surface elevation NA feet MSL

Well Drilled For: Well Class: Type Equipment:

Domestic well within 330 feet: _____ yes X no

XX Oil _____ SWD _____ Infield XX Mud Rotary

Municipal well within one mile: _____ yes X no

XX Gas _____ Inj X Pool Ext. _____ Air Rotary

Surface pipe by Alternate: 1 X 2 _____

_____ OWWO _____ Expl _____ Wildcat _____ Cable

Depth to bottom of fresh water 200

If OWWO: old well info as follows:

Depth to bottom of usable water 200

Operator

Surface pipe planned to be set 600

Well Name

Projected Total Depth 5400 feet

Comp Date Old Total Depth

Formation... Mississippian

I certify that well will comply with K.S.A. 55-101, et seq., plus eventually plugging hole to KCC specifications.

_____ cementing will be done immediately upon setting production casing.

Date .. 11-22-85 Signature of Operator or Agent R. B. Einhorn Title... Vice President

RCH/KW/E

For KCC Use:

Conductor Pipe Required feet; Minimum Surface Pipe Required feet per AN 1 2


This Authorization Expires 5-25-86 Approved By 11-25-85 R

Must be filed with the K.C.C. five (5) days prior to commencing well
This card void if drilling not started within six (6) months of date received by K.C.C.

Important procedures to follow:

1. Notify District office before setting surface casing.
2. Set surface casing by circulating cement to the top.
3. File completion forms ACO-1 with K.C.C. within 90 days of well completion, following instructions on ACO-1, side 1, and including copies of wireline logs.
4. Notify District office 48 hours prior to old well workover or re-entry.
5. Prior to filing Intent, prepare a proposed plugging plan in case well is D & A, then obtain approval of plan when calling district office prior to setting surface pipe.
6. Submit plugging report (CP-4) to K.C.C. after plugging is completed.
7. Obtain an approved injection docket number before disposing of salt water.
8. Notify K.C.C. within 10 days when injection commences or terminates.
9. If an alternate 2 completion, cement in the production pipe from below any usable water to surface within 120 days of spud date.

A Regular Section of Land 1 Mile = 5,280 Ft.

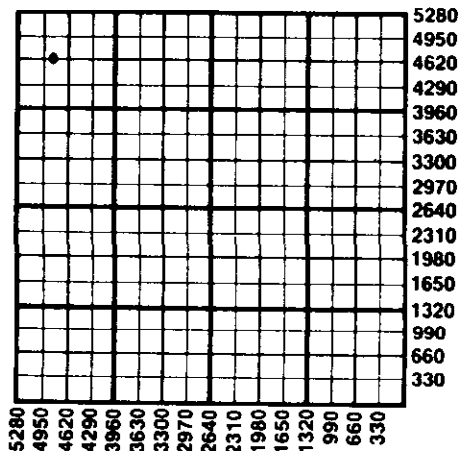

RECEIVED
STATE CORPORATION COMMISSION

NOV 25 1985
11-25-85
CONSERVATION DIVISION
Wichita, Kansas

State Corporation Commission of Kansas
Conservation Division
200 Colorado Derby Building
Wichita, Kansas 67202
(316) 263-3238