

STATE CORPORATION COMMISSION OF KANSAS
OIL & GAS CONSERVATION DIVISION
WELL COMPLETION OR RECOMPLETION FORM
ACO-1 WELL HISTORY
DESCRIPTION OF WELL AND LEASE

Operator: License # 3456
Name AFG Energy, Inc.
Address P. O. Box 605
City/State/Zip Russell, Kansas 67665

Purchaser Koch Oil Co.
Wichita, Kansas

Operator Contact Person Terry Piesker
Phone 913-483-6213

Contractor: License # 5302
Name Red Tiger Drilling Company

Wellsite Geologist Steve Parker
Phone 316-263-5172

Designate Type of Completion
 New Well Re-Entry Workover

Oil SWD Temp Abd
 Gas Inj Delayed Comp.
 Dry Other (Core, Water Supply etc.)

If OWNED: old well info as follows:
Operator
Well Name
Comp. Date Old Total Depth

WELL HISTORY

Drilling Method:
 Mud Rotary Air Rotary Cable
1/27/89 2/6/89 2-17-89
Spud Date Date Reached TD Completion Date
3,620' 3535
Total Depth PBTD
Amount of Surface Pipe Set and Cemented at 957 feet
Multiple Stage Cementing Collar Used? Yes No
If yes, show depth set feet
If alternate 2 completion, cement circulated from feet depth to w/ SX cmt
Cement Company Name Allied Cementing
Invoice #

API NO. 15-165-21,458-0000
County Rush
SW/4 NE/4 NW/4 10 16S 17W East
Sec. Twp. Rge. X West

4290 Ft North from Southeast Corner of Section
3630 Ft West from Southeast Corner of Section
(Note: Locate well in section plat below)

Lease Name Urban Well # 1

Field Name Unnamed Pleasant View, NW

Producing Formation Lansing-Kansas City


Elevation: Ground 1992 KB 1997

Section Plat

RECEIVED
STATE CORPORATION COMMISSION

MAR 27 1989

CONSERVATION DIVISION
Wichita, Kansas

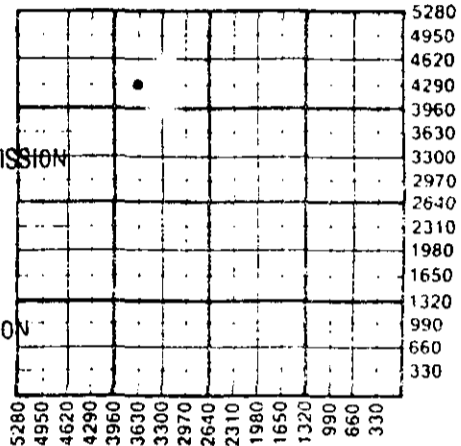

WATER SUPPLY INFORMATION

Disposition of Produced Water: Disposal
Docket # Repressuring

Questions on this portion of the ACO-1 call:
Water Resources Board (913) 296-3717

Source of Water:
Division of Water Resources Permit #

Groundwater Ft North from Southeast Corner
(Well) Ft West from Southeast Corner of
Sec Twp Rge East West

X Surface Water 1200 Ft North from Southeast Corner
(Stream, pond, etc) 2800 Ft West from Southeast Corner
Sec 33 Twp 15S Rge 16W East X West

Steve Kisner, Bison, Ks. 67520
Other (explain)
(purchased from city, R.W.O. #)

INSTRUCTIONS: This form shall be completed in triplicate and filed with the Kansas Corporation Commission, 200 Colorado Derby Building, Wichita, Kansas 67202, within 120 days of the spud date of any well. Rule 82-3-130, 82-3-107 and 82-3-106 apply.
Information on side two of this form will be held confidential for a period of 12 months if requested in writing and submitted with the form. See rule 82-3-107 for confidentiality in excess of 12 months.
One copy of all wireline logs and drillers time log shall be attached with this form. Submit CP-4 form with all plugged wells. Submit CP-111 form with all temporarily abandoned wells.

All requirements of the statutes, rules and regulations promulgated to regulate the oil and gas industry have been fully complied with and the statements herein are complete and correct to the best of my knowledge.

Signature Terry W. Piesker

Title General Manager Date 3-27-89

Subscribed and sworn to before me this 23rd day of March 1989

Notary Public Marcia Yost

Date Commission Expires

March 23rd 1989
NOTARY PUBLIC
Marcia Yost
10-28-91

K.C.C. OFFICE USE ONLY
 Letter of Confidentiality Attached
 Wireline Log Received
 Drillers Timelog Received
Distribution
 KCC SWD/Rep NGPA
 KGS Plug Other
(Specify)
3-27-89
Form ACO-1 (5-86)

Sec. 10 Twp. 16 Rge. 17E2