

M.L.B.

TYPE

AFFIDAVIT OF COMPLETION FORM

ACO-1 WELL HISTORY

SIDE ONE

Two (2) copies of this form shall be filed with the Kansas Corporation Commission, 200 Colorado Derby Building, Wichita, Kansas 67202, within thirty (30) days after the completion of a well, regardless of how the well was completed.

Attach separate letter of request if the information is to be held confidential. If confidential, only file one copy. Information on Side One will be of public record and Side Two will then be held confidential.

Applications must be made on dual completion, commingling, salt water disposal, injection and temporarily abandoned wells.

Attach one copy only wireline logs (i.e. electrical log, sonic log, gamma ray neutron log, etc.). (Rules 82-2-105 & 82-2-125) KCC# (316) 263-3238.

LICENSE # 6234 EXPIRATION DATE 6-30-83

OPERATOR M.L. Brown Co. API NO. 15-033-20,563-00-00

ADDRESS 200 Sutton Place COUNTY Comanche

Wichita, KS 67202 FIELD WILMORE, EAST

\*\* CONTACT PERSON Vern Haselhorst PROD. FORMATION Miss.  
PHONE 316/265-4651

PURCHASER Kansas Gas Supply LEASE V.L. SMITH

ADDRESS Box 300 WELL NO. 1

Tulsa, Okla. 74102 WELL LOCATION 245'W & 130'N of NWNW

DRILLING Abercrombie Drilling, Inc. 200 Ft. from North Line and

CONTRACTOR ADDRESS 801 Union Center 85 Ft. from West Line of

Wichita, KS 67202 the NW (Qtr.) SEC 26 TWP 31 S RGE 17 W.

PLUGGING None

CONTRACTOR ADDRESS

TOTAL DEPTH 5070' PBTD

SPUD DATE 6/12/82 DATE COMPLETED

ELEV: GR 1971' DF 1974' KB 1976'


DRILLED WITH (CABLE) (ROTARY) (AIR) TOOLS.

DOCKET NO. OF DISPOSAL OR REPRESSURING WELL BEING USED TO DISPOSE OF WATER FROM THIS LEASE

Amount of surface pipe set and cemented 493.20' DV Tool Used? NO

THIS AFFIDAVIT APPLIES TO: (Circle ONE) Oil Gas, Shut-in Gas, Dry, Disposal, Injection, Temporarily Abandoned, OWWO. Other

ALL REQUIREMENTS OF THE STATUTES, RULES AND REGULATIONS PROMULGATED TO REGULATE THE OIL AND GAS INDUSTRY HAVE BEEN FULLY COMPLIED WITH.

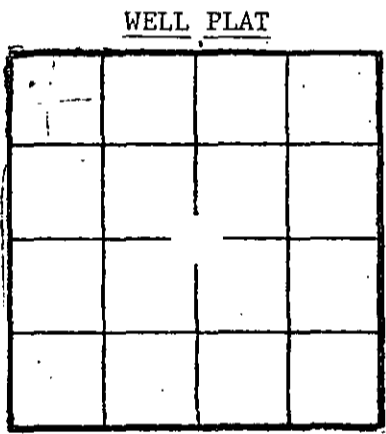

(Office Use Only)  
 KCC   
 KGS   
 SWD/REP   
 PLG.


A F F I D A V I T

Vern Haselhorst, being of lawful age, hereby certifies that:

I am the Affiant, and I am familiar with the contents of the foregoing Affidavit. The statements and allegations contained therein are true and correct.

*Vern Haselhorst*  
(Name)

SUBSCRIBED AND SWORN TO BEFORE ME this 3rd day of November, 1982.

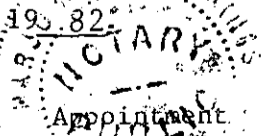

*Marjorie P. Jennings*  
 Marjorie P. Jennings (NOTARY PUBLIC) COMMISSION

NOV 4 1982

\*\* The person who can be reached by phone regarding any questions concerning this information. Conservation Division, Wichita, Kansas