

STATE CORPORATION COMMISSION OF KANSAS  
OIL & GAS CONSERVATION DIVISION

WELL COMPLETION OR RECOMPLETION FORM  
ACO-1 WELL HISTORY

DESCRIPTION OF WELL AND LEASE

Operator: License # 5171  
Name TXO PRODUCTION CORP.  
Address 200 W. Douglas, Suite 300  
City/State/Zip Wichita, KS 67202

Operator Contact Person Harold R. Trapp  
Phone 316-265-9441 Ext. 261

Contractor: License # 5107  
Name H-30 Drilling, Inc.

Wellsite Geologist Robert L. Laymon  
Phone 316-685-0874

PURCHASER Dry Hole

Designate Type of Completion  
 New Well  Re-Entry  Workover  
 Oil  SWD  Temp Abd  
 Gas  Inj  Delayed Comp.  
 Dry  Other (Core, Water Supply etc.)

If OWNQ: old well info as follows:  
Operator  
Well Name  
Comp. Date Old Total Depth

WELL HISTORY

Drilling Method:  
 Mud Rotary  Air Rotary  Cable  
10-21-84 10-31-84 10-31-84  
Spud Date Date Reached TD Completion Date  
5100' n/a  
Total Depth PBD

Amount of Surface Pipe Set and Cemented at....feet  
8-5/8" @ 535' w/400 SXS

Multiple Stage Cementing Collar Used?  Yes  No  
If yes, show depth set....feet

If alternate 2 completion, cement circulated  
from....feet depth to....w/....SX cmt

API NO. 15- 033-20,664-00-00  
County Comanche  
SW NW SE 29 31S 17W  East  
..... Sec..... Twp..... Rge.....  West

..... Ft North from Southeast Corner of Section  
..... Ft West from Southeast Corner of Section  
(Note: Locate well in section plat below)


Lease Name MOBERLEY "B" Well # 1

Field Name Wilmore

Producing Formation Dry Hole

Elevation: Ground 2015 KB 2026

Section Plat

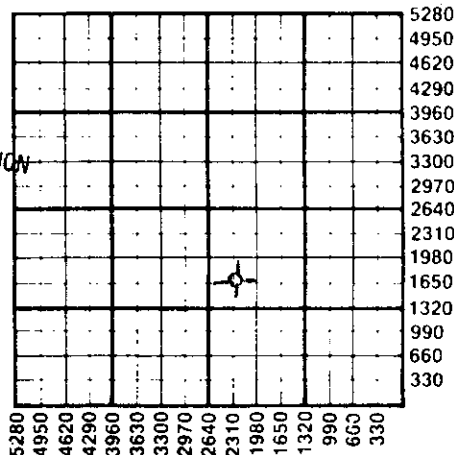

WATER SUPPLY INFORMATION

Source of Water: n/a  
Division of Water Resources Permit #

Groundwater.....Ft North from Southeast Corner  
(Well) .....Ft West from Southeast Corner of  
Sec Twp Rge  East  West

Surface Water.....Ft North from Southeast Corner  
(Stream,pond etc).....Ft West from Southeast Corner  
Sec Twp Rge  East  West

Other (explain) .....  
(purchased from city, R.W.D.#)

Disposition of Produced Water:  Disposal  
 Repressuring

Docket # NONE

RECEIVED  
STATE CORPORATION COMMISSION  
NOV 08 1981  
CONSERVATION DIVISION  
Wichita, Kansas

INSTRUCTIONS: This form shall be completed in duplicate and filed with the Kansas Corporation Commission, 200 Colorado Derby Building, Wichita, Kansas 67202, within 90 days after completion or recompletion of any well. Rule 82-3-130 and 82-3-107 apply. Information on side two of this form will be held confidential for a period of 12 months if requested in writing and submitted with the form. See rule 82-3-107 for confidentiality in excess of 12 months. One copy of all wireline logs and drillers time log shall be attached with this form. Submit CP-4 form with all plugged wells. Submit CP-111 form with all temporarily abandoned wells.

All requirements of the statutes, rules and regulations promulgated to regulate the oil and gas industry have been fully complied with and the statements herein are complete and correct to the best of my knowledge.

Signature Harold R. Trapp  
Title District Geologist Date 11-7-84

Subscribed and sworn to before me this 7th day of November 1984

Notary Public Sandra Lou Felter  
Date Commission Expires 1-30-88

Sandra Lou Felter  
NOTARY PUBLIC  
State of Kansas  
My Appt. Expires 1-30-88

K.C.C. OFFICE USE ONLY  
F  Letter of Confidentiality Attached  
C  Wireline Log Received  
C  Drillers Timelog Received  
Distribution  
 KCC  SWD/Rep  NGPA  
 KGS  Plug  Other  
(Specify)