

15-007-30259-0000

STATE OF KANSAS  
STATE CORPORATION COMMISSION

Give All Information Completely  
Make Required Affidavit  
Mail or Deliver Report to:  
Conservation Division  
State Corporation Commission  
211 No. Broadway  
Wichita, Kansas


JAN 11 1966

WELL PLUGGING RECORD

K.W.B., INC.

Barber County, Sec. 9 Twp. 34S Rge. 12 (E) (W)

NORTH R 12 W

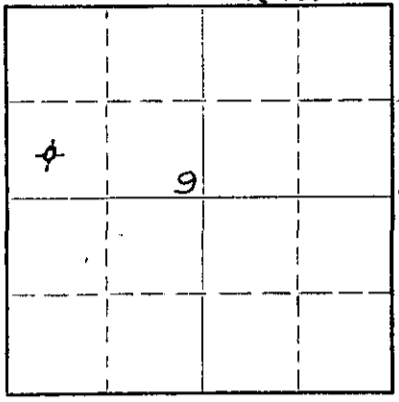

Locate well correctly on above Section Plat

Location as "NE/CNW/SW" or footage from lines SW NW  
Lease Owner K.W.B. Oil Property Management, Inc.  
Lease Name Cook-McCullough Well No. 1  
Office Address 913 Kennedy Building, Tulsa, Oklahoma  
Character of Well (completed as Oil, Gas or Dry Hole) Dry Hole  
Date well completed 1-7 1966  
Application for plugging filed 1-7 1966  
Application for plugging approved 1-7 1966  
Plugging commenced 1-7 1966  
Plugging completed 1-7 1966  
Reason for abandonment of well or producing formation Dry Hole

If a producing well is abandoned, date of last production \_\_\_\_\_ 19\_\_\_\_  
Was permission obtained from the Conservation Division or its agents before plugging was commenced? Yes

Name of Conservation Agent who supervised plugging of this well Archie V. Elving  
Producing formation \_\_\_\_\_ Depth to top \_\_\_\_\_ Bottom \_\_\_\_\_ Total Depth of Well \_\_\_\_\_ Feet  
Show depth and thickness of all water, oil and gas formations.

OIL, GAS OR WATER RECORDS

CASING RECORD

FORMATION	CONTENT	FROM	TO	SIZE	PUT IN	PULLED OUT
<p><b>RECEIVED</b> STATE CORPORATION COMMISSION JAN 26 1966 1-26-66 CONSERVATION DIVISION Wichita, Kansas</p>						

Describe in detail the manner in which the well was plugged, indicating where the mud fluid was placed and the method or methods used in introducing it into the hole. If cement or other plugs were used, state the character of same and depth placed, from \_\_\_\_\_ feet to \_\_\_\_\_ feet for each plug set.

4752 - 350' Heavy rotary mud  
350' Plug, 35 sacks cement  
350 - 40 Heavy rotary mud  
40 - GL Plug, 5 sacks cement in rat hole

(If additional description is necessary, use BACK of this sheet)

Name of Plugging Contractor Peel Brothers, Inc.  
Address Box 359, Hoisington, Kansas

STATE OF Kansas, COUNTY OF Barton, ss.  
Peel Brothers, Inc. (employee of owner) of the above-described well, being first duly sworn on oath, says: That I have knowledge of the facts, statements, and matters herein contained and the log of the above-described well as filed and that the same are true and correct. So help me God. PEEL BROTHERS, INC.  
(Signature) Wendell C. Peel  
Wendell C. Peel, President  
Box 359, Hoisington, Kansas  
(Address)

SUBSCRIBED AND SWORN TO before me this 10th day of January, 19 66

My commission expires 6-21-66  
Ethel S. Williamson  
Ethel S. Williamson Notary Public.

RECEIVED

15-007-30259-0000

JAN 11 1966

K.W.B., INC.

DRILLER'S LOG

RTL

Well Owner: K.W.B. Oil Property Management, Inc.  
 Farm Name: Cook-McCullough #1  
 Date Started: 12-20-65  
 Date Completed: 1-7-66  
 Total Depth: 4752

SW NW  
 Section 9-34S-12W  
 Barber County, Kansas

Casing: 8-5/8" casing set at 429' cemented

Contractor: Peel Brothers, Inc.

Figures below show bottoms of formations:

Shale and Shells	0	-	1760
Shale and Lime			3885
Lime and Shale			4300
Lime			4752
Total Depth			4752

RECEIVED  
 STATE CORPORATION

JAN 26 1966  
 1-26-66  
 CONSERVATION  
 Wichita, Kan.

This is to certify that the above information is to the best of our knowledge true and correct.

PEEL BROTHERS, INC.

*Wendell C. Peel*  
 Wendell C. Peel  
 President

SUBSCRIBED AND SWORN to before me on this 10th day of January, 1966.

*Ethel S. Williamson*  
 Ethel S. Williamson  
 Notary Public

My Commission expires 6-21-66