

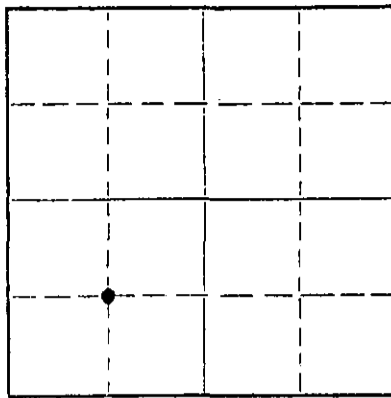
STATE OF KANSAS
STATE CORPORATION COMMISSION

Form CP-4

Give All Information Completely
Make Required Affidavit
Mail or Deliver Report to:
Conservation Division
State Corporation Commission
212 No. Market
Wichita, Kansas

WELL PLUGGING RECORD

NORTH



Locate well correctly on above
Section Plat

Barber County, Sec. 10 Twp. 34 Rge. 12 (E) W (W)
Location as "NE/CNW/SW" or footage from lines. C SW
Lease Owner Lee Phillips Oil Co.
Lease Name Cook Well No. 1
Office Address 1532 Vickers KSB & T Bldg., Wichita, Kansas
Character of Well (completed as Oil, Gas or Dry Hole) Dry Hole
Date well completed 10-19 1971
Application for plugging filed 10-19 1971
Application for plugging approved 10-19 1971
Plugging commenced 10-19 1971
Plugging completed 10-19 1971
Reason for abandonment of well or producing formation Dry Hole

If a producing well is abandoned, date of last production 19____
Was permission obtained from the Conservation Division or its agents before plugging was commenced? Yes

Name of Conservation Agent who supervised plugging of this well Russ Berberstein
Producing formation _____ Depth to top _____ Bottom _____ Total Depth of Well _____ Feet
Show depth and thickness of all water, oil and gas formations.

OIL, GAS OR WATER RECORDS

CASING RECORD

FORMATION	CONTENT	FROM	TO	SIZE	PUT IN	PULLED OUT
Surface pipe		-0-	105	13"	105	None
Surface pipe		-0-	336	8 5/8"	336	None

Describe in detail the manner in which the well was plugged, indicating where the mud fluid was placed and the method or methods used in introducing it into the hole. If cement or other plugs were used, state the character of same and depth placed, from _____ feet to _____ feet for each plug set.

Filled hole with heavy mud.

#1 plug set @ 300' with 35 sks. cement.

#2 plug set @ 40' with 10 sks. cement.

#3 plug set in rat hole with 2 sks. cement.

RECEIVED
STATE CORPORATION COMMISSION
OCT 26 1971
CONSERVATION DIVISION
Wichita, Kansas

(If additional description is necessary, use BACK of this sheet)

Name of Plugging Contractor Sweetman Drilling, Inc.
Address Box 645, Great Bend, Kansas 67530

STATE OF Kansas, COUNTY OF Barton, ss.
Gary L. Hawk

well, hereby sworn on oath, says: That I have knowledge of the facts, statements, and matters herein contained and the log of the above described well, filed and that the same are true and correct. So help me God.

(Signature)

Box 645, Great Bend, Kansas 67530

(Address)

SUBSCRIBED AND SWORN to before me this 22nd day of October, 1971

Mary Ann Schwamborn

Notary Public.

My commission expires 7-10-73

WELL LOG
Cook #1
C SW 10-34-12 W
Barber County, Kansas

Name of Operator: Lee Phillips Oil Company
1532 Vickers KSB & T Bldg.
Wichita, Kansas 67202

Date Completed: October 19, 1971

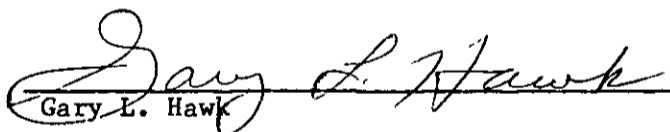
<u>FROM</u>	<u>TO</u>	
0	70	Sand
70	974	Red Bed & Shale
974	1670	Shale & Shells
1670	3706	Shale & Lime
3706	3734	Sand
3734	3955	Lime & Shale
3955	4690	Lime
4690		Total Depth

RECEIVED
STATE CORPORATION COMMISSION
OCT 26 1971
CONSERVATION DIVISION
Wichita, Kansas

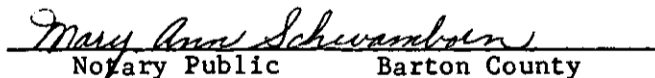
STATE OF KANSAS

COUNTY OF BARTON ss

Gary L. Hawk, Secretary of Sweetman Drilling, Inc., being first duly sworn on oath says: That I have knowledge of the facts, statements and matters herein contained and the log of the above described well as filed and that the same are true and correct.


Gary L. Hawk

Subscribed and sworn before me this 22nd day of October, 1971.


Notary Public Barton County

My Commission Expires 7-10-73

