


STATE OF KANSAS  
STATE CORPORATION COMMISSION

## WELL PLUGGING RECORD

Give All Information Completely  
Make Required Affidavit  
Mail or Deliver Report to  
Conservation Division  
State Corporation Comm.  
245 North Water  
Wichita, KS 67202

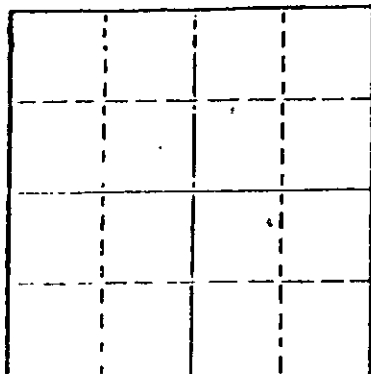

Locate well correctly on above  
Section Plat

Barber County. Sec. 13 Twp. 34S Rge. 10W E/W  
Location as "NE/CNW $\frac{1}{4}$ SW $\frac{1}{4}$ " or footage from lines  
SW NE

Lease Owner Juniper Petroleum Corporation  
Lease Name Betty Well No. 32-13  
Office Address 1660 Lincoln, Suite 2410, Denver, CO  
Character of Well (Completed as Oil, Gas or Dry Hole)  
Dry Hole

Date Well completed Jan. 24 1979  
Application for plugging filed (verbally) Jan. 24 1979  
Application for plugging approved (verbally) Jan. 24 1979  
Plugging commenced Jan. 24 1979  
Plugging completed Jan. 24 1979

Reason for abandonment of well or producing formation

No commercial quantity of oil or gas encountered

If a producing well is abandoned, date of last production  
19

Was permission obtained from the Conservation Division or  
its agents before plugging was commenced? Yes

Name of Conservation Agent who supervised plugging of this well Bill Owens  
Producing formation Depth to top Bottom Total Depth of Well 5040'  
Show depth and thickness of all water, oil and gas formations.

## OIL, GAS OR WATER RECORDS

## CASING RECORD

FORMATION	CONTENT	FROM	TO	SIZE	PUT IN	PULLED OUT

Describe in detail the manner in which the well was plugged, indicating where the mud fluid  
was placed and the method or methods used in introducing it into the hold. If cement or other  
plugs were used, state the character of same and depth placed, from feet to  
feet for each plug set.

T.D. 5040'

Set 1st plug at 300' with 40 sacks

2nd plug at 40' with  $\frac{1}{2}$  sack of hulls and plugged with 12 sacks

3 sacks in rathole

Cement by Halliburton.

Job was complete at 12:30 p.m., 1-24-79

(If additional description is necessary, use BACK of this sheet)

Name of Plugging Contractor Abercrombie Drilling, Inc.

STATE OF Kansas COUNTY OF Sedgwick, ss.  
Jack L. Partridge, Asst. Sec.-Treas. (employee of owner) or (owner or operator)  
of the above-described well, being first duly sworn on oath, says: That I have knowledge of  
the facts, statements, and matters herein contained and the log of the above-described well  
as filed and that the same are true and correct. So help me God.



(Signature)

*Jack L. Partridge*

801 Union Center, Wichita, Kansas  
(Address)

SUBSCRIBED AND SWORN TO before me this 31st day of January, 19 79

*Sherrie L. Brooks*  
Sherrie L. Brooks Notary Public.

My commission expires 8-21-82

OPERATOR: Juniper Petroleum Corporation  
CONTRACTOR: Abercrombie Drilling, Inc.  
WELL NAME: Betty #32-13  
LOCATION: SW NE, Section 13-34S-10W  
Barber County, Kansas  
SPUD DATE: January 09, 1979  
COMPLETION DATE: January 24, 1979

0	1506	Red bed and shale
1506	1795	Lime and shale
1795	1983	Shale and lime
1983	2205	Lime and shale
2205	2942	Shale and lime
2942	3172	Lime and shale
3172	3389	Shale and lime
3389	3545	Lime and shale
3545	3800	Shale and lime
3800	3897	Sand
3897	4100	Lime and shale
4100	4249	Shale and lime
4249	5040	Lime and shale
	5040	Rotary Total Depth

Spud hole at 4:00 p.m., January 9, 1979. Drilled 312' of 12 $\frac{1}{4}$ " hole. Ran 7 joints of used 8-5/8" - 28# casing. Set at 312' with 225 sacks of common cement, 3% Ca.Cl., 2% gel. Cement did circulate. Plug was down at 12:30 a.m., January 10, 1979.

T.D. 5040'. Set 1st plug at 300' with 40 sacks, 2nd plug at 40' with  $\frac{1}{2}$  sack of hulls and plugged with 12 sacks, 3 sacks in rathole. Job was complete at 12:30 p.m., January 24, 1979.

## SAMPLE TOPS:

Anhydrite 1370'  
B/Anhydrite 1390'

STATE OF KANSAS )  
COUNTY OF SEDGWICK ) ss

Jack L. Partridge, Assistant Secretary-Treasurer of Abercrombie Drilling, Inc., does hereby state that the above and foregoing is a true and correct copy of the log of the Betty #32-13, SW NE, Section 13-34S-10W, Barber County, Kansas.

ABERCROMBIE DRILLING, INC.

BY Jack L. Partridge  
Jack L. Partridge  
Assistant Secretary-Treasurer

Subscribed and sworn to before me, a Notary Public, in and for the county and state aforesaid, as of this 31st day of January 1979.



Sherrie L. Brooks  
Sherrie L. Brooks, Notary Public

My commission expires 8-21-82.