


Give All Information Completely  
Make Required Affidavit  
Mail or Deliver Report to:  
Conservation Division  
State Corporation Commission  
212 No. Market  
Wichita, Kansas

WELL PLUGGING RECORD

Barber County, Sec. 13 Twp. 34S Rge. 10 (W)

Location as "NE/CNW/SW" or footage from lines SE SW NW  
Lease Owner Champlin Petroleum Company  
Lease Name Skaggs Well No. 1  
Office Address P. O. Box 308, Ellinwood, Kansas 67526  
Character of Well (completed as Oil, Gas or Dry Hole) Dry Hole  
Date well completed January 27 19 70  
Application for plugging filed January 27 19 70  
Application for plugging approved January 27 19 70  
Plugging commenced January 27 19 70  
Plugging completed January 27 19 70  
Reason for abandonment of well or producing formation

If a producing well is abandoned, date of last production 19  
Was permission obtained from the Conservation Division or its agents before plugging was commenced? Yes

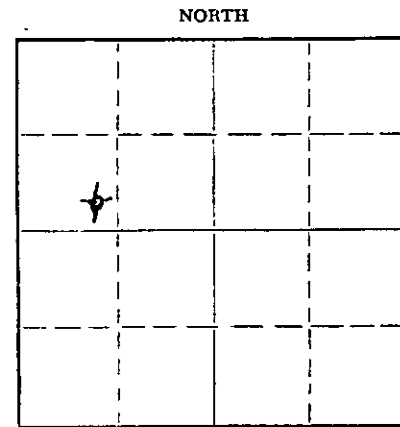

Locate well correctly on above Section Plat

Name of Conservation Agent who supervised plugging of this well G. R. Biberstein  
Producing formation \_\_\_\_\_ Depth to top \_\_\_\_\_ Bottom \_\_\_\_\_ Total Depth of Well 5100 Feet  
Show depth and thickness of all water, oil and gas formations.

OIL, GAS OR WATER RECORDS

CASING RECORD

FORMATION	CONTENT	FROM	TO	SIZE	PUT IN	PULLED OUT
				8 5/8" OD	220'	None

RECEIVED  
STATE CORPORATION COMMISSION  
JAN 30 1970  
CONSERVATION DIVISION  
Wichita, Kansas

01-30-1970

Describe in detail the manner in which the well was plugged, indicating where the mud fluid was placed and the method or methods used in introducing it into the hole. If cement or other plugs were used, state the character of same and depth placed, from \_\_\_\_\_ feet to \_\_\_\_\_ feet for each plug set.

Filled hole with mud from 5100' TD to 210', pushed plug and 1/2 sack of hulls, tightly rolled, to 210' and dumped in 25 sacks of cement. Filled hole to 40' with mud and pushed plug and 1/2 sack of hulls rolled tight to 40' and dumped in 10 sacks cement filling hole to surface. Put 2 sacks cement in rat hole.

(If additional description is necessary, use BACK of this sheet)  
Name of Plugging Contractor Lauck Drilling Company, Inc.  
Address 301 S. Broadway, Wichita, Kansas

STATE OF Kansas, COUNTY OF Barton, ss.  
J. W. Meyers (employee of owner) or (owner or operator) of the above-described well, being first duly sworn on oath, says: That I have knowledge of the facts, statements, and matters herein contained and the log of the above-described well as filed and that the same are true and correct. So help me God.

(Signature) *J. W. Meyers*  
J. W. Meyers, District Operations Manager  
P. O. Box 308, Ellinwood, Kansas  
(Address)

SUBSCRIBED AND SWORN TO before me this 29th day of January, 19 70

My commission expires 5/22/70

*N. Kenneth Stivers*  
N. Kenneth Stivers Notary Public.

15-007-20139-00-00

Champlin Petroleum Company

(Black Drilling Company, Contractor)

Franklin Skaggs #1

SE SW NW Sec. 13-34S-1E  
Barber County, Kansas

Commenced: January 9, 1970

Completed: January 27, 1970

Casing Record: 219' 8-5/8" Cemented with 200 sacks Cement.

Stratigraphic Log

	15
Shale & Shells	160
Shale & Shells	849
Shale	940
Shale & Shells	1570
Lime & Shale	2045
Shale & Shells	2210
Shale & Lime	2950
Lime & Shale	2575
Shale & Lime	3750
Lime & Shale	3830
Sand	3932
Shale	3950
Lime	4070
Lime & Shale	4145
Lime	4545
Lime & Shale	4588
Chert	4608
Chert & Lime	4655
Lime	4720
Lime & Shale	4795
Shale	4865
Shale & Lime	4900
Lime	4905
Shale & Lime	4917
Shale & Chert	4935
Shale	4955
Shale & Chert	5000
Shale & Sand	5014
Sand	5100 RTD

RECEIVED  
STATE CORPORATION COMMISSION  
FEB 24 1970  
CONSERVATION DIVISION  
Wichita, Kansas

02-24-1970