


STATE OF KANSAS
STATE CORPORATION COMMISSION

WELL PLUGGING RECORD

Give All Information Completely
Make Required Affidavit
Mail or Deliver Report to
Conservation Division
State Corporation Comm.
245 North Water
Wichita, KS 67202

Barber County, Sec. 17 Twp. 34S Rge. 10WE/W
Location as "NE/CNW $\frac{1}{2}$ SW $\frac{1}{2}$ " or footage from lines
C NW NE

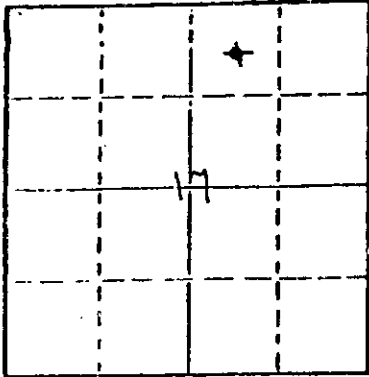

Locate well correctly on above
Section Plot

Lease Owner Oil Property Management, Inc.
Lease Name Page Well No. 1
Office Address Insurance Bldg., Wichita, Kansas 67202
Character of Well (Completed as Oil, Gas or Dry Hole) dry hole

Date Well completed November 15 1979
Application for plugging filed November 15 1979
Application for plugging approved November 15 1979
Plugging commenced November 15 1979
Plugging completed November 15 1979

Reason for abandonment of well or producing formation dry

If a producing well is abandoned, date of last production 19

Was permission obtained from the Conservation Division or its agents before plugging was commenced? yes

Name of Conservation Agent who supervised plugging of this well Wm. T. Owen

Producing formation Depth to top Bottom Total Depth of Well 4745

Show depth and thickness of all water, oil and gas formations.

OIL, GAS OR WATER RECORDS

CASING RECORD

| FORMATION | CONTENT | FROM | TO | SIZE | PUT IN | PULLED OUT |
|-----------|---------|------|----|------|--------|------------|
| | | | | | | |
| | | | | | | |
| | | | | | | |
| | | | | | | |

Describe in detail the manner in which the well was plugged, indicating where the mud fluid was placed and the method or methods used in introducing it into the hold. If cement or other plugs were used, state the character of same and depth placed, from feet to feet for each plug set.

Set first plug at 270' with 40 sacks
Set second plug at 40' with 10 sacks
Five sacks in the rat hole

RECEIVED
STATE CORPORATION COMMISSION
NOV 27 1979
CONSERVATION DIVISION
Wichita, Kansas

(If additional description is necessary, use BACK of this sheet)

Name of Plugging Contractor Union Drilling Co., Inc.

STATE OF Kansas COUNTY OF Sedgwick, ss.

R. D. Messinger (employee of owner) or (owner or operator) of the above-described well, being first duly sworn on oath, says: That I have knowledge of the facts, statements, and matters herein contained and the log of the above-described well as filed and that the same are true and correct. So help me God.

(Signature)

505 Union Center, Wichita, Kansas 67202
(Address)

SUBSCRIBED AND SWORN TO before me this 19th day of November, 19 79

My commission expires 6-2-82

Cynthia L. Romey

Notary Public.

CONTRACTOR'S WELL LOG

OPERATOR: Oil Property Management, Inc.
 CONTRACTOR: Union Drilling Co., Inc.
 LEASE NAME: #1 Page
 LOCATION: C NW NE Section 17-34S-10W
 Barber County, Kansas
 COMMENCED: November 5, 1979
 COMPLETED: November 15, 1979

| | | | |
|------|------|-------------------|------------------------------|
| 0 | 275 | Red bed | Set 8-5/8" @279' w/200 sacks |
| 275 | 1010 | Red bed and shale | |
| 1010 | 3404 | Shale | |
| 3404 | 4520 | Shale and lime | |
| 4520 | 4734 | Lime and shale | |
| 4734 | 4745 | Lime. | |

We certify that the above and foregoing is a true and correct copy of the log on the #1 Page, C NW NE Section 17-34S-10W, Barber County, Kansas.

Union Drilling Co., Inc.

R. D. Messinger
 R. D. Messinger


STATE OF KANSAS)
) SS
 COUNTY OF SEDGWICK)

Subscribed and sworn to before me, a Notary Public, in and for the aforesaid County and State as of this 19th day of November, 1979.

My appointment expires:

6-2-82

Cynthia L. Romey
 Cynthia L. Romey-Notary Public

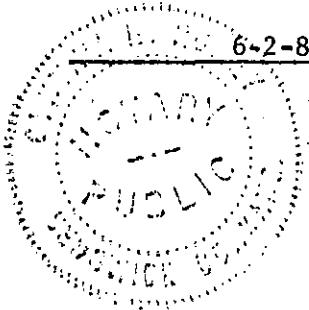

RECEIVED
 STATE CORPORATION COMMISSION
 11-27-1979
 NOV 27 1979
 CONSERVATION DIVISION
 Wichita, Kansas