

STATE OF KANSAS
STATE CORPORATION COMMISSION


WELL PLUGGING RECORD

Give All Information Completely
Make Required Affidavit
Mail or Deliver Report to:
Conservation Division
State Corporation Commission
800 Biting Building
Wichita, Kansas

Comanche County, Sec. 2 Twp. 31S Rge. (E) 17(W)

Location as "NE/CNW&SW&" or footage from lines Ctr NE NE
Lease Owner Grahamhart-Miller Oil Company
Lease Name Kennedy "A" Well No. 1
Office Address Petroleum Building, Wichita, Kansas
Character of Well (completed as Oil, Gas or Dry Hole) Dry Hole
Date well completed June 27, 1956 19
Application for plugging filed June 27, 1956 19
Application for plugging approved June 27, 1956 19
Plugging commenced June 28, 1956 19
Plugging completed June 28, 1956 19
Reason for abandonment of well or producing formation Dry Hole

NORTH

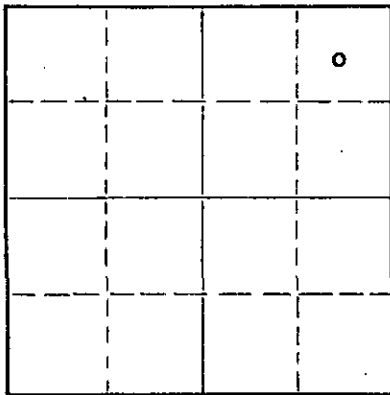

Locate well correctly on above
Section Plat

If a producing well is abandoned, date of last production _____ 19____
Was permission obtained from the Conservation Division or its agents before plugging was commenced? Yes

Name of Conservation Agent who supervised plugging of this well M. A. Rives, Box 8, Pratt, Kansas
Producing formation _____ Depth to top _____ Bottom _____ Total Depth of Well 513 1/2 Feet
Show depth and thickness of all water, oil and gas formations.

OIL, GAS OR WATER RECORDS

CASING RECORD

FORMATION	CONTENT	FROM	TO	SIZE	PUT IN	PULLED OUT
				8 5/8"	300	None

Describe in detail the manner in which the well was plugged, indicating where the mud fluid was placed and the method or methods used in introducing it into the hole. If cement or other plugs were used, state the character of same and depth placed, from _____ feet to _____ feet for each plug set.

Filled hole with heavy mud to 300'.
Set plug at 300'. Used 1/4 sack hulls
and 20 sacks cement. Filled hole with
heavy mud to 35'. Set plug at 35'.
Used 1/4 sack hulls and 10 sacks cement.

(If additional description is necessary, use BACK of this sheet)

Name of Plugging Contractor Graham-Michaelis Drilling Company
Address 1005 East Second, Wichita, Kansas

STATE OF Kansas, COUNTY OF Sedgwick, ss.
J. A. Gilliland (employee of owner) or (~~owner or operator~~) of the above-described well, being first duly sworn on oath, says: That I have knowledge of the facts, statements, and matters herein contained and the log of the above-described well as filed and that the same are true and correct. So help me God.

(Signature) J. A. Gilliland
Petroleum Building, Wichita, Kansas
(Address)

SUBSCRIBED AND SWORN TO before me this 13th day of July, 19 56

Juanita L. Lewis
Notary Public.

My commission expires November 5, 1958

PLUGGING
FILE SEC 2 T 31 R 17W
BOOK PAGE 76 LINE 10

KENNEDY "A" #1

Well Record

Location: NE/4 NE/4 Sec. 2-31-17
Comanche County, Kansas

Commenced: June 6, 1956
Completed: June 28, 1956
(rotary)

Operator: Messner-Rinehart Drilling Co.
505 Petroleum Building
Wichita, Kansas

Contractor: Graham-Michaelis Drilling Co.
1005 East Second Street
Wichita 1, Kansas

Casing Record: 8-5/8" @ 300' w/200 sacks cement

LOG

Sand	120
Shale	200
Red Bed	300
Red Bed & Shale	1750
Shale & Shells	1900
Line & Shale	2235
Line	2450
Line & Shale	4110
Line	4253
Line & Shale	4356
Line	4590
Line & Chert.	4653
Line	4975
Line & Chert.	4995
Line	5025
Line & Chert.	5111
Line	5134, RTD.

STATE OF KANSAS)
) ss.
COUNTY OF SEDGWICK)

The undersigned, Graham-Michaelis Drilling Company, hereby certifies that the above log is a true and correct log of the formations encountered in drilling the above well as reflected by the Daily Drilling Report.

GRAHAM-MICHAELIS DRILLING COMPANY

By John L. James
John L. James
Geologist.

Subscribed and sworn to before me
this fifth day of July, 1956,

Mary L. Barnes

My commission expires: 11/7/57.

PLUGGING			
FILE	SEC. 2	T 31	R 17W
BOOK	PAGE 76	LINE 10	