

15-007-16636-0000

STATE OF KANSAS  
STATE CORPORATION COMMISSION

Form CP-4

Give All Information Completely  
Make Required Affidavit  
Mail or Deliver Report to:  
Conservation Division  
State Corporation Commission  
212 No. Market  
Wichita, Kansas 67202

WELL PLUGGING RECORD

Barber County, Sec. 21 Twp. 34S Rge. 12W (E) (W)

Location as "NE/CNW/SW" or footage from lines C/SW/4 NW/4

Lease Owner Robert F. White

Lease Name Cook Well No. 1

Office Address 714 Union Center, Wichita, Kansas 67202

Character of Well (completed as Oil, Gas or Dry Hole) Gas

Date well completed February 3 19 60

Application for plugging filed November 30 19 70

Application for plugging approved 19


Plugging commenced 12/10/70 19

Plugging completed 12/14/70 19

Reason for abandonment of well or producing formation No longer economic

If a producing well is abandoned, date of last production November 30 19 70

Was permission obtained from the Conservation Division or its agents before plugging was commenced? yes

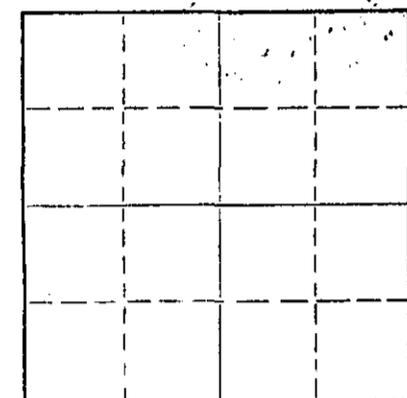

Locate well correctly on above Section Plat

Name of Conservation Agent who supervised plugging of this well Biberstein

Producing formation Mississippi Depth to top 4738' Bottom 4825' Total Depth of Well 4825 Feet

Show depth and thickness of all water, oil and gas formations.

OIL, GAS OR WATER RECORDS (Notched at 4772, 4765, and 4760) CASING RECORD

FORMATION	CONTENT	FROM	TO	SIZE	PUT IN	PULLED OUT
		0	271	8-5/8"	271'	0
		0	4824	4-1/2"	4824	3185'

Describe in detail the manner in which the well was plugged, indicating where the mud fluid was placed and the method or methods used in introducing it into the hole. If cement or other plugs were used, state the character of same and depth placed, from feet to feet for each plug set.

Checked hole, sanded hole to 4750' and set 4 sacks of cement.  
Loaded hole with water, shot pipe at 4030', 3850', 3658', 3386',  
3202', pulled 98 joints. Set rock bridge at 250' and ran 4 yards  
ready mix. Tallied pipe.

PLUGGING COMPLETE.

RECEIVED  
STATE CORPORATION COMMISSION  
JAN 4 1971  
CONSERVATION DIVISION  
Wichita, Kansas

(If additional description is necessary, use BACK of this sheet)

Name of Plugging Contractor KNIGHT CASING PULLING CO., INC.

Address CHASE, KANSAS

STATE OF KANSAS, COUNTY OF RICE, ss.

NOEL J. KNIGHT (employee of owner) or (owner or operator) of the above-described

well, being first duly sworn on oath, says: That I have knowledge of the facts, statements, and matters herein contained and the log of the above-described well as filed and that the same are true and correct. So help me God.

(Signature) Noel Knight

Chase, Kansas

(Address)

SUBSCRIBED AND SWORN to before me this 30th day of December, 19 70

Margaret Melcher  
Notary Public.

My commission expires 2/15/71

## ROTARY DRILLING LOG

OPERATOR: Edwin G. Bradley, et al  
COOK #1,  
C SW NW Sec. 21-34-12W,  
Barber County, Kansas

CONTRACTOR: Prime Drilling Company  
COMM: 1/16/60  
COMP: 2/3/60

Remarks: Set 8-5/8" surface casing  
at 271' cemented with 225  
sacks cement.

## Formations:

Surface Clay & Rock	25'
Red Rock	130'
Red Bed	272'
Red Bed & Shells	590'
Shale & Shells	1010'
Anhydrite	1040'
Shale & Shells	1630'
Lime & Shale	1795'
Lime	1949'
Lime & Shale	2055'
Shale & Lime	2150'
Lime & Shale	2565'
Shale & Lime	2775'
Lime & Shale	2860'
Shale & Lime	3165'
Lime & Shale	3370'
Lime	3410'
Lime & Shale	3595'
Sandy Shale & Lime	3732'
Lime & Shale	3765'
Lime	3914'
Lime & Shale	4025'
Lime	4039'
Sandy Shale	4054'
Lime & Shale	4100'
Lime	4175'
Lime & Shale	4220'
Lime	4234'
Lime & Shale	4297'
Lime	4737'
Lime Cherty	4800'
Lime	4825'
Rotary Total Depth	4825'

RECEIVED  
STATE CORPORATION COMMISSION  
12-1-70  
DEC 1 - 1970  
CONSERVATION DIVISION  
Wichita, Kansas

Set 4-1/2" casing at 4824' cemented  
with 150 sacks Pozmix.

We certify the above log is true  
and correct to the best of our  
knowledge and belief.

PRIME DRILLING COMPANY

*R. R. McNicol*

R. R. McNicol