


WELL PLUGGING RECORD

Give All Information Completely
Make Required Affidavit
Mail or Deliver Report to:
Conservation Division
State Corporation Commission
211 No. Broadway
Wichita, Kansas

BARBER County. Sec. 21 Twp. 34 Rge. 12W (E) (W)

Location as "NE/CNW/SW" or footage from lines SW NE SW
Lease Owner SANTA FE PIPE & SUPPLY
Lease Name C. OLSON "C" Well No. 1
Office Address P. O. BOX 562 - GREAT BEND, KANSAS
Character of Well (completed as Oil, Gas or Dry Hole) GAS
Date well completed MARCH 11 19 56
Application for plugging filed NOVEMBER 29 19 63
Application for plugging approved DECEMBER 2 19 63
Plugging commenced DECEMBER 13 19 63
Plugging completed DECEMBER 17 19 63
Reason for abandonment of well or producing formation DEPLETED

NORTH

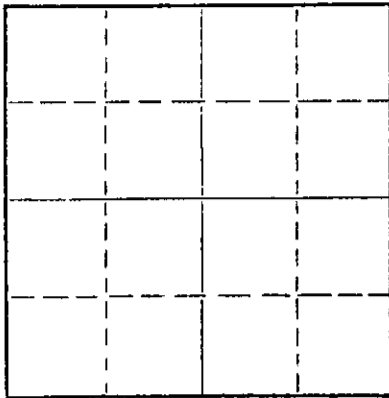

Locate well correctly on above
Section Plat

If a producing well is abandoned, date of last production 19
Was permission obtained from the Conservation Division or its agents before plugging was commenced?

Name of Conservation Agent who supervised plugging of this well
Producing formation Depth to top Bottom Total Depth of Well 4793' Feet
Show depth and thickness of all water, oil and gas formations.

OIL, GAS OR WATER RECORDS

CASING RECORD

FORMATION	CONTENT	FROM	TO	SIZE	PUT IN	PULLED OUT
				9 5/8"	353'	NONE
				5 1/2"	4792'	3623'

Describe in detail the manner in which the well was plugged, indicating where the mud fluid was placed and the method or methods used in introducing it into the hole. If cement or other plugs were used, state the character of same and depth placed, from feet to feet for each plug set.

PLUGGED BACK WITH SAND FROM 4760' TO 4680' - MIXED AND DUMPED 5 SACKS CEMENT FROM 4680' TO 4640'. PULLED CASING. MUDDERED HOLE TO 290'. SET 10' ROCK BRIDGE FROM 290' TO 280'. MIXED AND DUMPED 25 SACKS CEMENT FROM 280' TO 220'. MUDDERED HOLE FROM 220' TO 35'. SET 10' ROCK BRIDGE FROM 35' TO 25'. MIXED AND DUMPED 10 SACKS CEMENT FROM 25' TO BASE OF THE CELLAR.

RECEIVED
STATE CORPORATION COMMISSION

FEB 3 1964
2-3-64

CONSERVATION DIVISION
Wichita, Kansas

(If additional description is necessary, use BACK of this sheet)
Name of Plugging Contractor ACE PIPE PULLING COMPANY
Address P. O. BOX 304 - GREAT BEND, KANSAS

STATE OF KANSAS, COUNTY OF BARTON, ss.
T. L. NUTT (employed or owner) of (owner or operator) of the above-described well, being first duly sworn on oath, says: That I have knowledge of the facts, statements, and matters herein contained and the log of the above-described well as filed and that the same are true and correct. So help me God.

(Signature) T. L. Nutt
P. O. Box 562 - Great Bend, Kansas (Address)

SUBSCRIBED AND SWORN to before me this 31ST day of JANUARY 19 64

My commission expires JULY 31, 1966
Mary M. Guesnier Notary Public

15-007-10355-0000

WELL LOG BUREAU—KANSAS GEOLOGICAL SOCIETY
503 East Murdock, Wichita, Kansas


COPY

Company—MAGNOLIA PETROLEUM CO.
Farm—C. Olson "C" No. 1

SEC. 21 T. 34 R. 12W
SW NE SW

Total Depth. 4793
Comm. 1-21-56 Com. 3-11-56
Spec. or Treated.
Contractor. Graham-Messman-Rinehart Oil Co.
Issued. 8-18-56

County Barber
KANSAS

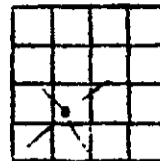

Elevation. 1456 DF

Production. 5,300,000 CFGPD

CASING:

9 5/8 @ 353' w/ 300 sx cmt.
5 1/2 @ 4792' w/ 150 sx cmt.

Figures indicate bottom of formations.

clay, shale & gypsum	251
shale	945
shale & anhydrite	1415
lime & shale	3087
shale & sand	3330
lime & shale	3551
shale, sand & lime	3795
shale & lime	4164
lime	4697
Mississippi	4725
Mississippi lime & chert	4760
chert	4772
lime	4793
Total Depth	

TOPS:

Lansing	3994
Kansas City	4302
Mississippian	4697

DST #1: 4700-25, open 1 hr. fr. bl.
faint odor gas IP, rec. 30' SOCM,
FP 15-15#, BHP 530#/20 min.

DST #2: 4725-60, open 1 1/2 hrs. good bl.
thruout, rec. 50' mud, FP 15-15#,
BHP 785#/30 min.

RECEIVED
STATE CORPORATION COMMISSION

FEB 3 1964
2-3-64
CONSERVATION DIVISION
Wichita, Kansas