

STATE OF KANSAS  
STATE CORPORATION COMMISSION

Form CP-4

WELL PLUGGING RECORD


Give All Information Completely  
Make Required Affidavit  
Mail or Deliver Report to:  
Conservation Division  
State Corporation Commission  
212 No. Market  
Wichita, Kansas

Comanche

County, Sec. 18 Twp. 31 Rge. 17 ~~EX~~ W (W)

Location as "NE/CNW/SW" or footage from lines 660' FSL & 1980' FWL  
Lease Owner Cities Service Oil Company  
Lease Name Ridge-Pepperd "A" Well No. 1  
Office Address Box 308, Great Bend, Kansas 67530  
Character of Well (completed as Oil, Gas or Dry Hole) Dry Hole  
Date well completed March 30 19 72  
Application for plugging filed March 30 19 72  
Application for plugging approved March 30 19 72  
Plugging commenced March 30 19 72  
Plugging completed March 30 19 72  
Reason for abandonment of well or producing formation Dry Hole

NORTH

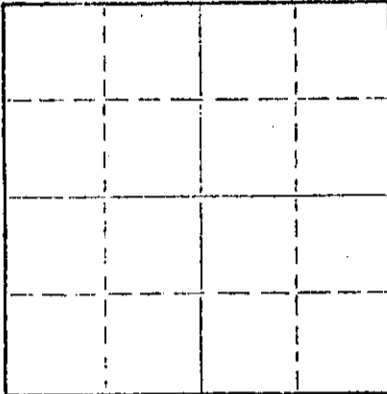

Locate well correctly on above Section Plat

If a producing well is abandoned, date of last production 19  
Was permission obtained from the Conservation Division or its agents before plugging was commenced? Yes

Name of Conservation Agent who supervised plugging of this well G. Russell Biberstein  
Producing formation \_\_\_\_\_ Depth to top \_\_\_\_\_ Bottom \_\_\_\_\_ Total Depth of Well 5071' Feet  
Show depth and thickness of all water, oil and gas formations.

OIL, GAS OR WATER RECORDS

CASING RECORD

FORMATION	CONTENT	FROM	TO	SIZE	PUT IN	PULLED OUT
				8-5/8"	530'	-0-
RECEIVED STATE CORPORATION COMMISSION APR 6 - 1972 CONSERVATION DIVISION Wichita, Kansas						

Describe in detail the manner in which the well was plugged, indicating where the mud fluid was placed and the method or methods used in introducing it into the hole. If cement or other plugs were used, state the character of same and depth placed, from \_\_\_\_\_ feet to \_\_\_\_\_ feet for each plug set.

5071' to 650' - Mud  
650' - Set Plug  
650' to 490' - Pumped 50 sacks of cement  
490' to 40' - Mud  
40' to Base of Cellar - Plug & 1/2 sack hulls - pumped  
15 sacks cement  
2 Sacks Cement in Mouse Hole  
8 Sacks Cement in Rat Hole


Well Record Attached

(If additional description is necessary, use BACK of this sheet)  
Name of Plugging Contractor Garvey Drilling Company (Halliburton Services)  
Address Box 1164, Great Bend, Kansas 67530

STATE OF Kansas, COUNTY OF Barton, ss.  
W. J. Devaney (employee of owner) or ~~owner or operator~~ of the above-described well, being first duly sworn, on oath, says: That I have knowledge of the facts, statements, and matters herein contained and the log of the above-described well as filed, and that the same are true and correct. So help me God.

(Signature) *W. J. Devaney*  
Box 308, Great Bend, Kansas 67530  
(Address)

Subscribed and sworn to before me this 5th day of April, 19 72

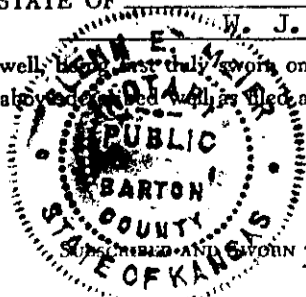

My commission expires June 3, 1973  
Notary Public.

# WELL RECORD

Company Cities Service Oil Company Well No. 1 Farm Ridge-Pepperd "A"  
 Location 660' FSL & 1980' FWL Sec. 18 T. 31 R. 17W  
 Elevation R.K.B. 2046' County Comanche State Kansas  
 Initial Prod. Dry Hole - P&A 3/30/72 Contractor Garvey Drilling Company  
 Acid None Drlg. Comm. March 17, 1972  
 T.D. Rotary T.D. 5069' - Log T.D. 5071' Drlg. Comp. March 30, 1972

CASING RECORD:

8-5/8" set at 530' with 260 sacks regular pozmix + 2% C.C. and 75 sacks common + 2% C.C.

FORMATION RECORD:

Clay	0 - 30'
Sand	65'
Clay	100'
Sand	160'
Shale & Redbed	1100'
Shale	1545'
Shale & Lime	4250'
Shale	4320'
Lime	5069' - T.D.

DRILL STEM TESTS:

D.S.T. #1 - 4958-4990' Mississippi - 32'.  
 Open 10 mins. - Strong blow -  
 S.I. 30 mins. - Open 60 mins. -  
 Gas to surface in 1 min. - 49 MCF  
 in 10 mins. - 60 MCF in 60 mins.  
 Recovered 55' Gas Cut Drill Mud.  
 ISIP 1550# - 30 mins.; IF 47#;  
 FF 47#; FSIP 1533# - 30 mins.  
 B.H.T. 118°F.

D.S.T. #2 - 4990-5020'. Open 10 mins. Strong blow.  
 S.I. 30 mins. Open 60 mins. Gas  
 to surface 10 mins. Too small to  
 measure - 6 mins. S.I.  
 Recovered 75' G.C.D.M.  
 ISIP 1356# - IF 28# - FF 47# -  
 FSIP 1318#.

LOG TOPS:

Heebner	4156'	-2110'
Toronto	4170'	-2124'
Lansing	4324'	-2278'
Base Kansas City	4768'	-2722'
Marmaton	4779'	-2733'
Ft. Scott	4903'	-2859'
Cherokee	4912'	-2866'
Mississippi	4966'	-2920'
Log T.D.	5071'	

SLOPE TESTS:

532'	-	1/2°
1100'	-	1/2°
2085'	-	3/4°
2320'	-	1/2°
2854'	-	3/4°
3490'	-	3/4°
4130'	-	1/2°
4690'	-	1/2°

RECEIVED  
 STATE CORPORATION COMMISSION  
 APR 6 - 1972  
 CONSERVATION DIVISION  
 Wichita, Kansas