

15-033-20240-00-00

STATE OF KANSAS
STATE CORPORATION COMMISSION

WELL PLUGGING RECORD

Give All Information Completely
Make Required Affidavit
Mail or Deliver Report to
Conservation Division
State Corporation Comm.
245 North Water
Wichita, KS 67202

Comanche County, Sec. 20 Twp. 31S Rge. 17W E/W
Location as "NE/CNW $\frac{1}{4}$ SW $\frac{1}{4}$ " or footage from lines
C NW $\frac{1}{4}$ NW $\frac{1}{4}$

Lease Owner Graham-Michaelis Corporation
Lease Name Pepperd Well No. 2-20


Office Address P. O. Box 247, Wichita, Kansas 67201
Character of Well (Completed as Oil, Gas or Dry Hole)
Dry Hole

Date Well completed February 14, 1978
Application for plugging filed Verbal 1978
Application for plugging approved February 16, 1978
Plugging commenced February 14, 1978
Plugging completed February 14, 1978

Reason for abandonment of well or producing formation
Non Commercial

If a producing well is abandoned, date of last production
none 19

Was permission obtained from the Conservation Division or
its agents before plugging was commenced? Yes - verbal

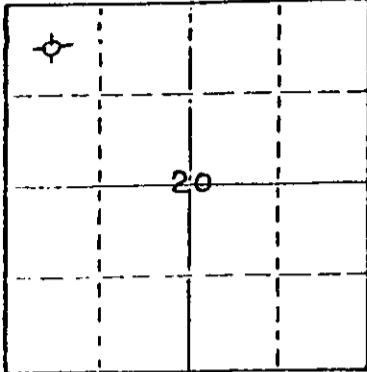

Locate well correctly on above
Section Plat

Name of Conservation Agent who supervised plugging of this well William T. Owen
Producing formation _____ Depth to top _____ Bottom _____ Total Depth of Well 5065'
Show depth and thickness of all water, oil and gas formations.

OIL, GAS OR WATER RECORDS

CASING RECORD

FORMATION	CONTENT	FROM	TO	SIZE	PUT IN	PULLED OUT
				8 5/8"	571'	none

Describe in detail the manner in which the well was plugged, indicating where the mud fluid
was placed and the method or methods used in introducing it into the hold. If cement or other
plugs were used, state the character of same and depth placed, from _____ feet to
_____ feet for each plug set.

40 sacks cement at bottom of surface casing

120 sacks cement from 40' to 0'

3 sacks cement in rathole

RECEIVED
STATE CORPORATION COMMISSION

MAR 06 1978

CONSERVATION DIVISION
Wichita, Kansas

(If additional description is necessary, use BACK of this sheet)

Name of Plugging Contractor _____

STATE OF Kansas COUNTY OF Sedgwick, ss.


Jack L. Yinger (employee of owner) or (owner or operator)
of the above-described well, being first duly sworn on oath, says: That I have knowledge of
the facts, statements, and matters herein contained and the log of the above-described well
as filed and that the same are true and correct. So help me God.

(Signature) Jack L. Yinger
P. O. Box 247, Wichita, Kansas 67201
(Address)

SUBSCRIBED AND SWORN TO before me this 3rd day of March, 1978

Muriel F. C. Jeram
Notary Public.

My commission expires

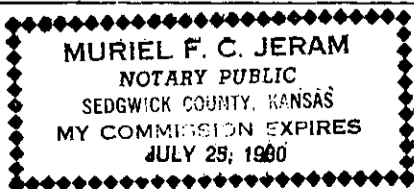

GABBERT-JONES, INC.
 WICHITA, KANSAS
 DRILLERS' WELL LOG

Pepperd #2-20
 NW NW Sec 20-31S-17W
 Comanche County Kansas

Commenced: 2-2-78

Completed: 2-14-78

OPERATOR: GRAHAM-MICHAELIS CORPORATION

From	Depth to	Formation	Remarks
0	91		91' of 13" set by
91	327	Sand-Shale-Redbed	Jr's Rathole Service
327	900	Redbed-Shale	
900	2748	Shale	
2748	2950	Lime-Shale	
2950	3737	Shale-Lime	
3737	4212	Lime-Shale	
4212	4396	Shale-Lime	Ran 14 jts of 23# 8 5/8" csg
4396	4860	Lime-Shale	set @ 571' Cemented w/
4860	4925	Lime	225 sks Lightweight - 3% CC
4925	4985	Lime-Shale	Followed by 175 sks Common
4985	5065	Lime	3% CC PD @ 6:00 p.m.
	5065 - TD		2-3-78

DRY & ABANDONED

STATE OF KANSAS)
) SS
 COUNTY OF SEDGWICK)

I, the undersigned, being duly sworn on oath, state that the above Drillers' Well Log is true and correct to the best of my knowledge and belief and according to the records of this office.

GABBERT-JONES, INC.

James S. Sutton II
 JAMES S. SUTTON II

Subscribed and sworn to before me this 22nd day of February, 1978.

Elizabeth J. Edwards
 ELIZABETH J. EDWARDS-NOTARY PUBLIC

My Commission expires February 6, 1979.



RECEIVED
 STATE CORPORATION COMMISSION
 MAR 06 1978
 CONSERVATION DIVISION
 Wichita, Kansas