


WELL PLUGGING RECORD

Give All Information Completely  
Make Required Affidavit  
Mail or Deliver Report to:  
Conservation Division  
State Corporation Commission  
212 No. Market  
Wichita, Kansas

NORTH

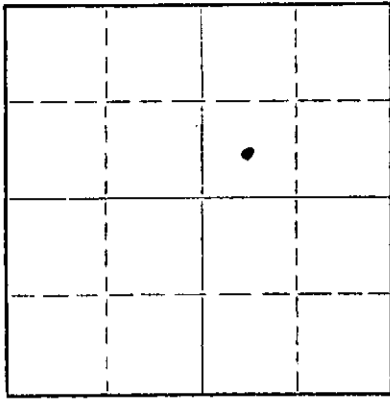

Locate well correctly on above  
Section Plat

Comanche County, Sec. 30 Twp. 31S Rge. (E) 17 (W)  
Location as "NE/CNWxSWx" or footage from lines C SW 1/4 NE 1/4  
Lease Owner Anadarko Production Company  
Lease Name Baker "B" Well No. 1  
Office Address Box 351 Liberal, Kansas 67901  
Character of Well (completed as Oil, Gas or Dry Hole) Dry Hole  
Date well completed May 9 1969  
Application for plugging filed July 21 1969  
Application for plugging approved July 23 1969  
Plugging commenced August 9 1969  
Plugging completed August 9 1969  
Reason for abandonment of well or producing formation Dry Hole

If a producing well is abandoned, date of last production 19\_\_\_\_  
Was permission obtained from the Conservation Division or its agents before plugging was commenced? Yes

Name of Conservation Agent who supervised plugging of this well Ralph Warren, Pratt, Kansas 67124  
Producing formation \_\_\_\_\_ Depth to top \_\_\_\_\_ Bottom \_\_\_\_\_ Total Depth of Well 5240 Feet  
Show depth and thickness of all water, oil and gas formations.

OIL, GAS OR WATER RECORDS

CASING RECORD

FORMATION	CONTENT	FROM	TO	SIZE	PUT IN	PULLED OUT
				8 5/8"	1030'	None
				4 1/2"	5239'	4518'

Describe in detail the manner in which the well was plugged, indicating where the mud fluid was placed and the method or methods used in introducing it into the hole. If cement or other plugs were used, state the character of same and depth placed, from \_\_\_\_\_ feet to \_\_\_\_\_ feet for each plug set.

Spotted 10 sacks cement @ 4920', 30 sacks cement @ 500' and 10 sacks cement from 30' to surface. Hole filled with mud between each plug.


RECEIVED  
STATE CORPORATION COMMISSION  
SEP 4 1969  
CONSERVATION DIVISION  
Wichita, Kansas

(If additional description is necessary, use BACK of this sheet)  
Name of Plugging Contractor Sargents Casing Pulling Service  
Address Box 506 Liberal, Kansas 67901

STATE OF Kansas, COUNTY OF Seward, ss.  
V. K. Downey (employee of owner) or (owner or operator) of the above-described

above-described well as filed and that the same are true and correct. So help me God.

(Signature) V. K. Downey  
Box 351 Liberal, Kansas 67901 V. K. Downey  
(Address)

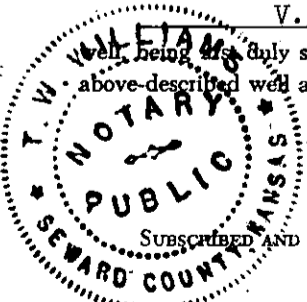

Subscribed AND SWORN to before me this 2nd day of September, 1969

My Commission Expires April 28, 1971

T. W. Williams  
T. W. Williams Notary Public.

My commission expires \_\_\_\_\_

DRILLER'S LOG

WELL NAME: Raker "B" No. 1 ; COMPANY OPERATING: Acadarko Production Company  
 ADDRESS OF COMPANY: Box 351 Liberal, Kansas 67901

WELL LOCATION: 0  $\frac{1}{4}$  SW  $\frac{1}{4}$  NE  $\frac{1}{4}$ ,  
3300 ft. North of South line,  
5145 ft. East of West line: Sec. 30, Twp. 31S, Rge. 17W, Comanche County, Kansas

DRILLING STARTED 4-14, 19 69; DRILLING COMPLETED 4-30, 19 69  
 WELL COMPLETED 5-9, 19 69; WELL CONNECTED \_\_\_\_\_, 19 \_\_\_\_\_

ELEVATION: 2083 ft. Ground Level; CHARACTER OF WELL (Oil, Gas, or Dry Hole) Dry Hole

OIL OR GAS SANDS OR ZONES - PERFORATIONS - ACIDIZING AND FRACTURING INFORMATION					
Name	From	To	No. of Shots	Gallons Used	Kind Used
Mississippi	5050'	5058'	16	1000	15% N.E.

CASING RECORD

Size	Amount Set	Sacks of Cement	Amount Tapped
8 5/8"	1030'	600	None
4 1/2"	5239'	160	None

FORMATION RECORD

Formation	Top	Bottom	Formation	Top	Bottom
Clay & Sand	0'	125'			
Redbed	125'	1022'			
Argillite	1022'	1031'			
Shale & Redbed	1031'	1295'			
Shale & Shells	1295'	2055'			
Shale w/Lime streaks	2055'	2274'			
Lime & Shale	2274'	4650'			
Lime	4650'	5240'			
Total Depth	5240'				

**RECEIVED**  
 STATE CORPORATION COMMISSION

JUL 23 1969

CONSERVATION DIVISION  
 Wichita, Kansas

RESULTS of INITIAL PRODUCTION TEST: \_\_\_\_\_