


Give All Information Completely
Make Required Affidavit
Mail or Deliver Report to:
Conservation Division
State Corporation Commission
211 No. Broadway
Wichita, Kansas

WELL PLUGGING RECORD

Comanche County. Sec. 31 Twp. 31S Rge. (E)17 (W)
Location as "NE/CNWSW¼" or footage from lines C SW/4 NE/4
Lease Owner J. M. Huber Corporation
Lease Name York Well No. 1
Office Address P O Box 978, Liberal, Kansas
Character of Well (completed as Oil, Gas or Dry Hole) Dry hole
Date well completed October 3, 1962 1962
Application for plugging filed October 4, 1962 1962
Application for plugging approved October 4, 1962 1962
Plugging commenced October 4, 1962 1962
Plugging completed October 4, 1962 1962
Reason for abandonment of well or producing formation Dry hole

NORTH

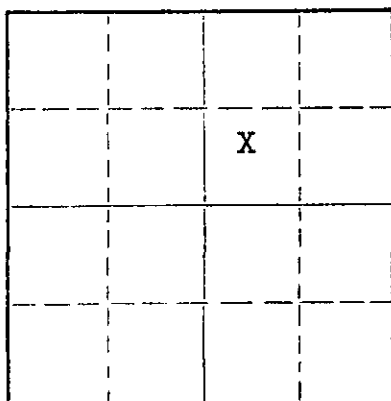

Locate well correctly on above
Section Plat

If a producing well is abandoned, date of last production None 19
Was permission obtained from the Conservation Division or its agents before plugging was commenced? Yes

Name of Conservation Agent who supervised plugging of this well Mr. Lac Kamp
Producing formation None Depth to top Bottom Total Depth of Well 5,310 Feet
Show depth and thickness of all water, oil and gas formations.

OIL, GAS OR WATER RECORDS

CASING RECORD

FORMATION	CONTENT	FROM	TO	SIZE	PUT IN	PULLED OUT
None				13 3/8	525	None

Describe in detail the manner in which the well was plugged, indicating where the mud fluid was placed and the method or methods used in introducing it into the hole. If cement or other plugs were used, state the character of same and depth placed, from feet to feet for each plug set.

Fill hole with mud to 450'. Put wood plug @ 450'; put 35 sacks cement plug on top of wood plug at 450'. Filled hole with mud to 30'; put 10 sack cement on top.

RECEIVED
STATE CORPORATION COMMISSION
NOV 9 1962
CONSERVATION DIVISION
Wichita, Kansas

(If additional description is necessary, use BACK of this sheet)

Name of Plugging Contractor Reaves Drilling Company
Address Cushing, Oklahoma

STATE OF Kansas, COUNTY OF Seward, ss.
Floyd L. Meade (employee of owner) or (owner or operator) of the above-described well, being first duly sworn on oath, says: That I have knowledge of the facts, statements, and matters herein contained and the log of the above-described well as filed and that the same are true and correct. So help me God.

(Signature) Floyd L. Meade
P O Box 978, Liberal, Kansas
(Address)

SUBSCRIBED AND SWORN to before me this 22nd. day of October, 19 62

My commission expires August 5, 1964
Lydia M. Hoops Notary Public.

4
J. M. HUBER CORPORATION

York No. 1

C-SW-NE

Sec. 31-31S-17W

Comanche County, Kansas

RECEIVED
COMMISSION

NOV 20 1962

CONSERVATION DIVISION
Wichita, Kansas

W E L L L O G

<u>From - To</u>	<u>FORMATION</u>
0 - 70	Surface Soil, Sand
70 - 530	Sand, Red Bed & Shells 13 3/8" set @ 525'
530 - 1,016	Sand, Red Bed
1,016 - 3,615	Shale - Lime
3,615 - 3,955	Lime
3,955 - 4,631	Shale - Lime
4,631 - 4,685	Lime
4,685 - 4,867	Lime - Shale
4,867 - 5,310	Lime
5,310	R T D

State of Kansas, County of Seward

I, Floyd L. Meade, do hereby certify that the foregoing is true and correct to the best of my knowledge and belief.

Floyd L. Meade
Floyd L. Meade

Subscribed and sworn to before me this 15th day of November,
1962.

Lydial M. Woods
Notary Public

My commission expires: August 5, 1964