

STATE OF KANSAS
STATE CORPORATION COMMISSION


WELL PLUGGING RECORD

Give All Information Completely
Make Required Affidavit
Mail or Deliver Report to:
Conservation Division
State Corporation Commission
800 Bitting Building
Wichita, Kansas

Barber County, Sec. 18 Twp. 35 Rge. 12 (X) W (W)

Location as "NE/CNW/SW" or footage from lines C-NW-NW
Lease Owner PETROLEUM, INC.
Lease Name Stutzman Well No. 1
Office Address Route 2 Great Bend, Kansas
Character of Well (completed as Oil, Gas or Dry Hole) Dry Hole
Date well completed September 9, 19 56
Application for plugging filed September 11, 19 56
Application for plugging approved September 9, 19 56
Plugging commenced September 9, 19 56
Plugging completed September 9, 19 56
Reason for abandonment of well or producing formation No Producing Zones

NORTH

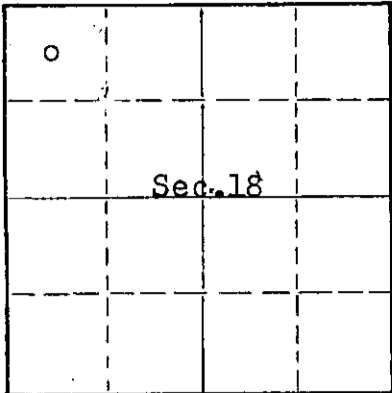

Locate well correctly on above Section Plat

If a producing well is abandoned, date of last production None 19
Was permission obtained from the Conservation Division or its agents before plugging was commenced? Yes

Name of Conservation Agent who supervised plugging of this well M. A. Rives Box 8 Pratt, Kansas

Producing formation ----- Depth to top --- Bottom --- Total Depth of Well 4,954 Feet

Show depth and thickness of all water, oil and gas formations.

OIL, GAS OR WATER RECORDS

CASING RECORD

FORMATION	CONTENT	FROM	TO	SIZE	PUT IN	PULLED OUT
				8 5/8 OD	301'	None

Describe in detail the manner in which the well was plugged, indicating where the mud fluid was placed and the method or methods used in introducing it into the hole. If cement or other plugs were used, state the character of same and depth placed, from _____ feet to _____ feet for each plug set.

Mud up with heavy mud to 300', pushed down 1 sack hulls to 300' followed by wooden plug. Placed 20 sacks cement through drill pipe on to plug. Mud up to 35' and place 1/2 sack hulls at 35' followed by wooden plug and 10 sacks cement to base of well cellar.

(If additional description is necessary, use BACK of this sheet)

Name of Plugging Contractor Garvey Drilling Co.
Address Route 2, Great Bend, Kansas

STATE OF Kansas, COUNTY OF Barton ss.
Don Searle (employee of owner) or (owner or operator) of the above-described

well, being first duly sworn on oath, says: That I have knowledge of the facts, statements, and matters herein contained and the log of the above-described well as filed and that the same are true and correct. So help me God.

(Signature) Don Searle

Route 2, Great Bend, Kansas (Address)

SUBSCRIBED AND SWORN TO before me this 17 th day of September, 19 56

[Signature] Notary Public.

My commission expires July 11, 1960

PLUGGING
FILE SEC. 18 T. 35 R. 12W
BOOK PAGE 98 LINE 4

7-19-56

15-007-00225-0000
WELL LOG

COMPANY PETROLEUM, INCORPORATED

SEC. 18 T. 35S R. 12W

FARM Stutzman NO. 1


LOC. C/NW, NW

TOTAL DEPTH 4954'

COUNTY Barber Co., Kansas

COMM. August 24, 1956 COMP. September 9, 1956

CONTRACTOR GARVEY DRILLING COMPANY

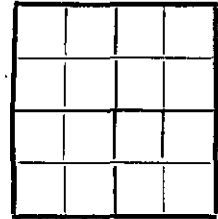

CASING 8 5/8" @ 301' W/200 sax.

ELEVATION 1434' DF

PRODUCTION D & A

FIGURES INDICATE BOTTOM OF FORMATIONS

130	Sand & clay	Elgin	3658
305	?	Heebner	3862
565	Shale	K. C.	4400
1585	Shale & shells	B. K. C.	4612
1890	Shale & lime		
2035	Lime		
3668	Shale & lime		
3854	Shale & sand		
4490	Lime & shale		
4509	Lime		
4846	Lime & shale		
4954	Lime		
4954	T. D.		

PLUGGING
FILE SEC. 18 T. 35 R. 12W
BOOK PAGE 98 LINE 4

RECORDED
INDEXED
9-19-56

State of KANSAS }
County of BARTON } ss:

I, Verne A. Morris of Garvey Drilling Co.

upon oath state that the above and foregoing is a true and correct copy of the log of the #1 Stutzman well

Verne A. Morris
by Doug Boyd

Subscribed and sworn to before me this 14th day of September 19 56

My Commission Expires: July 11, 1960

Jed L. Brown
NOTARY PUBLIC