

STATE OF KANSAS
STATE CORPORATION COMMISSION

WELL PLUGGING RECORD

DEC 5 1979

Give All Information Completely
Make Required Affidavit
Mail or Deliver Report to
Conservation Division
State Corporation Comm.
245 North Water
Wichita, KS 67202

Barber County. Sec. 4 Twp. 35S Rge. 12W E/W
Location as "NE/CNW $\frac{1}{4}$ SW $\frac{1}{4}$ " or footage from lines _____
NW NW NE

Lease Owner Ram Petroleum Corp.
Lease Name #1 Vogel Well No. _____


Office Address 826 Vickers/KSB&T Bldg., Wichita, Ks, 67202
Character of Well (Completed as Oil, Gas or Dry Hole) _____
dry hole

Date Well completed November 26, 1979
Application for plugging filed November 26, 1979
Application for plugging approved November 26, 1979
Plugging commenced November 26, 1979
Plugging completed November 26, 1979
Reason for abandonment of well or producing formation _____

dry
If a producing well is abandoned, date of last production _____
19____

Was permission obtained from the Conservation Division or its agents before plugging was commenced? Yes

Name of Conservation Agent who supervised plugging of this well Wm. T. Owen
Producing formation _____ Depth to top _____ Bottom _____ Total Depth of well 4905
Show depth and thickness of all water, oil and gas formations.

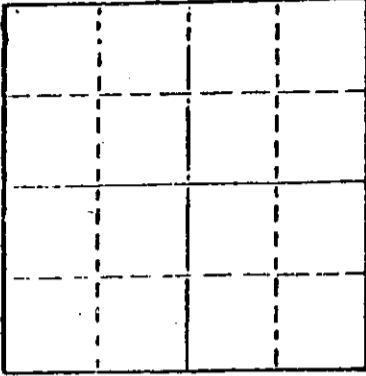

Locate well correctly on above Section Plot

OIL, GAS OR WATER RECORDS

CASING RECORD

FORMATION	CONTENT	FROM	TO	SIZE	PUT IN	PULLED OUT

Describe in detail the manner in which the well was plugged, indicating where the mud fluid was placed and the method or methods used in introducing it into the hold. If cement or other plugs were used, state the character of same and depth placed, from _____ feet to _____ feet for each plug set.

Set first plug at 270' with 40 sacks
Set second plug at 40' with 10 sacks
5 sacks in the rat hole

RECEIVED
STATE CORPORATION COMMISSION
DEC - 6 1979
12-6-79
CONSERVATION DIVISION
Wichita, Kansas

(If additional description is necessary, use BACK of this sheet)

Name of Plugging Contractor Union Drilling Co., Inc.

STATE OF Kansas COUNTY OF Sedgwick, ss.
R. D. Messinger (employee of owner) or (owner or operator)
of the above-described well, being first duly sworn on oath, says: That I have knowledge of the facts, statements, and matters herein contained and the log of the above-described well as filed and that the same are true and correct. So help me God.

(Signature) R. D. Messinger
505 Union Center, Wichita, Kansas 67202
(Address)

SUBSCRIBED AND SWORN TO before me this 29th day of November, 19 79

Cynthia L. Romey
Cynthia L. Romey Notary Public.

My commission expires 6-2-82

CONTRACTOR'S WELL LOG

OPERATOR:	Ram Petroleum Corp.	DEC 5 1979
CONTRACTOR:	Union Drilling Co., Inc.	
LEASE NAME:	#1 Vogel	
LOCATION:	NW NW NE Sec. 4-35S-12W	
	Barber County, Kansas	
COMMENCED:	11-16-79	
COMPLETED:	11-26-79	

0	1075	Red bed	Set 8 5/8" @282' w/300 Sacks
1075	4395	Shale	
4395	4548	Shale and lime	
4548	4739	Lime and shale	
4739	4837	Lime	
4837	4925	Lime and shale	

We certify that the above and foregoing is a true and correct copy of the log on the #1 Vogel, NW NW NE Section 4-35S-12W, Barber County, Kansas.

Union Drilling Co., Inc.

R. D. Messinger
 R. D. Messinger

STATE OF KANSAS)
) SS
 COUNTY OF SEDGWICK)

Subscribed and sworn to before me, a Nortary Public, in and for the aforesaid County and State as of this 29th day of November 1979.

My appointment expires:
6-2-82

Cynthia L. Roney
 Cynthia L. Roney-Nortary Public

RECEIVED
 STATE CORPORATION COMMISSION
 DEC - 6 1979
 12-6-79
 CONSERVATION DIVISION
 Wichita, Kansas