

15-007-01677-0000


STATE OF KANSAS  
STATE CORPORATION COMMISSION

WELL PLUGGING RECORD

Give All Information Completely  
Make Required Affidavit  
Mail or Deliver Report to:  
Conservation Division  
State Corporation Commission  
800 Bitting Building  
Wichita, Kansas

Barber County, Sec. 16 Twp. 34S Rge. 12 (W)

Location as "NE/CNW&SW" or footage from lines NE/4 SW/4 SW/4  
Lease Owner Monsanto Chemical Company  
Lease Name Vestal Well No. 1  
Office Address P. O. Box 580, Pratt, Kansas  
Character of Well (completed as Oil, Gas or Dry Hole) Dry Hole  
Date well completed February 15, 19 56  
Application for plugging filed February 22, 19 56  
Application for plugging approved February 23, 19 56  
Plugging commenced March 9, 19 56  
Plugging completed March 14, 19 56  
Reason for abandonment of well or producing formation Dry Hole

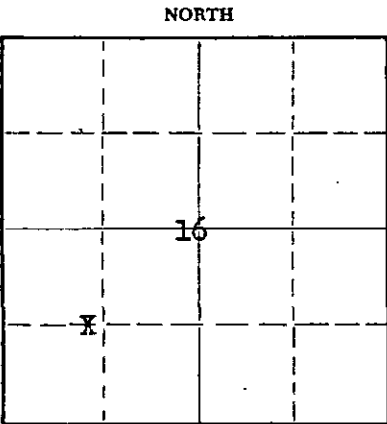

Locate well correctly on above Section Plat

If a producing well is abandoned, date of last production \_\_\_\_\_ 19\_\_\_\_  
Was permission obtained from the Conservation Division or its agents before plugging was commenced? Yes

Name of Conservation Agent who supervised plugging of this well Mr. Rives  
Producing formation \_\_\_\_\_ Depth to top \_\_\_\_\_ Bottom \_\_\_\_\_ Total Depth of Well 4800 Feet  
Show depth and thickness of all water, oil and gas formations.

OIL, GAS OR WATER RECORDS

CASING RECORD

FORMATION	CONTENT	FROM	TO	SIZE	PUT IN	PULLED OUT
				8-5/8"	348.55'	None
				5-1/2"	4778'	3750'

Describe in detail the manner in which the well was plugged, indicating where the mud fluid was placed and the method or methods used in introducing it into the hole. If cement or other plugs were used, state the character of same and depth placed, from \_\_\_\_\_ feet to \_\_\_\_\_ feet for each plug set.

Sand to 4700', 5 sacks of cement on top of sand,  
Heavy mud to 300', Set rock plug @ 300' with 20  
sacks of cement on top of plug, Heavy mud to 35',  
set rock plug @ 35' with 10 sacks of cement,  
Cement to base of cellar.

(If additional description is necessary, use BACK of this sheet)

Name of Plugging Contractor West Supply Company  
Address Chase, Kansas

STATE OF KANSAS, COUNTY OF PRATT, ss.  
J. B. Gibbs (employee of owner) or (owner/operator) of the above-described well, being first duly sworn on oath, says: That I have knowledge of the facts, statements, and matters herein contained and the log of the above-described well as filed and that the same are true and correct. So help me God.

(Signature) *J. B. Gibbs*  
P. O. Box 580, Pratt, Kansas  
(Address)

SUBSCRIBED AND SWORN TO before me this 15th day of March, 19 56

My commission expires September 19, 1959

*Mark J. Conkle*  
RECEIVED Notary Public.  
STATE CORPORATION COMMISSION

PLUGGING  
FILE SEC. 16 T 34 R 12W  
BOOK PAGE 40 LINE 22

MAR 16 1956  
3-16-56  
CONSERVATION DIVISION  
Wichita, Kansas

15-007-01677-0000

NO. 1 VESTAL

WELL RECORD

Location: Ctr NE SW SW, 16-34S-12W  
Barber County, Kansas

Commenced: January 25, 1956

Operator: Monsanto Chemical Company  
Lion Oil Company Division  
211 W-K-H Building, Wichita, Kansas

Completed: February 7, 1956

Elevation: 1482 KB (1472 Gr)

Contractor: Graham-Messman-Rinehart Drilling Co.  
1005 East Second, Wichita, Kansas

Production:

Casing Record: 8 5/8" @ 355' w/275 sacks cement  
5 1/2" @ 4776' w/150 sacks cement

.....L O G.....

Red Bed	356
Shale-Red Bed	1702
Shale-Lime	2172
Lime-Sandy Lime	2783
Lime-Shale	3003
Shale-Lime	3740
Sand-Shale	3948
Lime-Shale	4067
Lime	4269
Lime-Shale	4347
Lime	4454
Lime-Chert	4632
Chert-Lime	4705
Chert-Shale	4724
Chert-Miss	4750
Miss	4760
Lime	4800 R.T.D.

Sample Tops:

Mississippi 4697 (-3215)

The undersigned, GRAHAM-MESSMAN-RINEHART DRILLING COMPANY, hereby certifies that the above log is a true and correct log of the formation encountered in drilling the above well as reflected by the Daily Drilling Report.

GRAHAM-MESSMAN-RINEHART DRILLING COMPANY

By: \_\_\_\_\_

J. A. Gilliland

Subscribed and sworn to before me this 13th day of February, 1956.

Juanita L. Lewis  
Notary Public

My Commission Expires: November 5, 1958

RECEIVED  
ST. LOUIS, MO. FEBRUARY 13, 1956

MAY 1 1956  
S-1-56  
CONSERVATION DIVISION  
Wichita, Kansas

**PLUGGING**  
FILE SEC 16 T 34 R 12W  
BOOK PAGE 40 LINE 22