


STATE OF KANSAS  
STATE CORPORATION COMMISSION

WELL PLUGGING RECORD

Give All Information Completely  
Make Required Affidavit  
Mail or Deliver Report to  
Conservation Division  
State Corporation Comm.  
245 North Water  
Wichita, KS 67202

Comanche County, Sec. 28 Twp. 31 Rge. 17 E/W  
Location as "NE/CNW $\frac{1}{4}$ SW $\frac{1}{4}$ " or footage from lines  
230' NE C SW NW  
Lease Owner Patrick Petroleum Corporation  
Lease Name Uhl Well No. 1  
Office Address Suite 414, 200 E. First, Wichita 67202  
Character of Well (Completed as Oil, Gas or Dry Hole)  
Dry Hole  
Date Well completed 1/15/77 19  
Application for plugging filed 1/15/77 19  
Application for plugging approved 1/15/77 19  
Plugging commenced 1/15/77 19  
Plugging completed 1/15/77 19  
Reason for abandonment of well or producing formation  
If a producing well is abandoned, date of last production 19

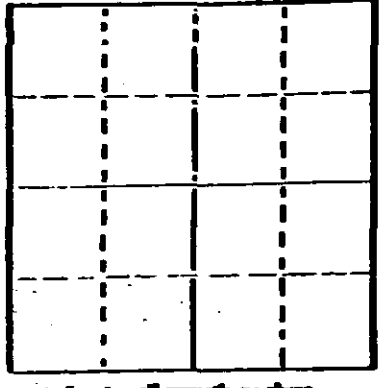

Name of Conservation Agent who supervised plugging of this well G. R. Biberstein  
Producing formation Depth to top Bottom Total Depth of Well 5030'  
Show depth and thickness of all water, oil and gas formations.

OIL, GAS OR WATER RECORDS

CASING RECORD

FORMATION	DEPTH	FEET	IN	THICK	PER IN	PULLED OUT
Surface	0	604.50'	8-5/8		yes	no
Conductor	0	60'	16"		yes	no

Describe in detail the manner in which the well was plugged, indicating where the mud fluid was placed and the method or methods used in introducing it into the hold. If cement or other plugs were used, state the character of same and depth placed, from feet to feet for each plug set.

Bottom plug at 300' with 35 sacks common cement  
Top bridge at 40' with 15 sacks common cement  
Rat hole with 5 sacks  
job complete at 8:30 a.m. 1/15/77

STATE CORPORATION COMMISSION  
JAN 24 1977  
CONSERVATION DIVISION  
WICHITA, KANSAS

(If additional description is necessary, use BACK of this sheet)

Name of Plugging Contractor Slawson Drilling Company, Inc.  
408 One Twenty Building, Wichita, Kansas 67202


STATE OF Kansas COUNTY OF Sedgwick, Mo.  
James C. Remsberg (employee of owner) or (owner or operator) of the above-described well, being first duly sworn on oath, says: That I have knowledge of the facts, statements, and matters herein contained and the log of the above-described well as filed and that the same are true and correct. So help me God.

(Signature) James C. Remsberg  
James C. Remsberg  
408 One Twenty Building, Wichita 67202  
(Address)

Subscribed and sworn to before me this 21 day of January, 1977

My commission expires January 17, 1981

Mary Lou Taylor  
Mary Lou Taylor Notary Public

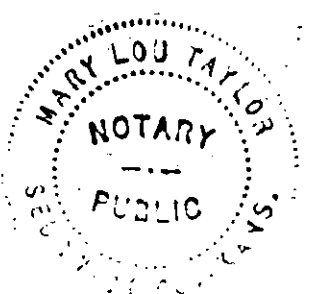

DRILLERS LOG

OPERATOR Patrick Petroleum Corporation  
Suite 414, 200 E. First Street  
Wichita, Kansas 67202

LEASE Uhl No. 1  
230' NE C SW NW Sec. 28-31S-17W  
Comanche County, Kansas

CONTRACTOR Slawson Drilling Company, Inc.  
408 One Twenty Building  
Wichita, Kansas 67202

RTD 5030'

COMMENCED: January 4, 1977

COMPLETED: January 15, 1977

CASING: 597.50' new 8-5/8" set at 604.50' 450 sx cement  
16" conductor pipe 0' to 60'

0' to 60' conductor pipe, open hole 7 cement  
60' to 100' Shale  
100' to 632' Red Bed & sand  
582' to 604' Plug and cement  
604' to 1132' Shale, etc.  
1132' to 2360' Shale  
2360' to 2775' Lime & Shale  
2775' to 3450' Shale & Lime  
3450' to 3808' Lime & Shale  
3808' to 4225' Shale & Lime  
4225' to 4885' Lime & Shale  
4885' to 4945' Lime  
4545' to 5030' Miss  
5030' RTD

STATE OF KANSAS  
COMMISSIONER OF REVENUE

JAN 24 1977

COMMISSIONER OF REVENUE  
Wichita, Kansas

STATE OF KANSAS

COUNTY OF SEDGWICK

I, James C. Remsberg, of the Slawson Drilling Company, Inc. hereby state that the above and foregoing is a true and accurate copy of the log of the No. 1 Uhl well.

*James C. Remsberg*  
James C. Remsberg

Subscribed and sworn to me on 21st day of January, 1977

*Mary Lou Taylor*  
Mary Lou Taylor, Notary

My commission expires January 17, 1981

