


STATE OF KANSAS
STATE CORPORATION COMMISSION
200 Colorado Derby Bldg.
Wichita, Kansas 67202

Form CP-4
Rev. 12-15-80

WELL PLUGGING RECORD

Give All Information Completely
Make Required Affidavit

COUNTY Comanche SEC. 16 TWP. 31S RGE. 17W #/W
Location as in quarters or footage from lines:
C N/2 NW NW

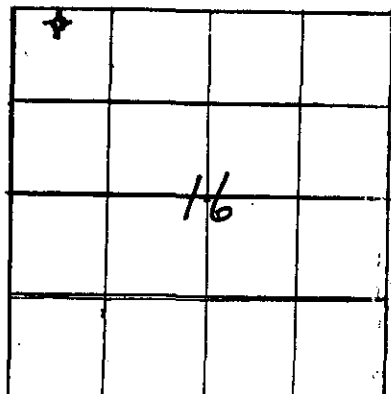

Locate Well
correctly on above
Section Platt.

Lease Owner Lee Banks
Lease Name Schoof-Kennedy Well No. 1
Office Address 200 W. Douglas, Suite 400, Wichita, Kansas 67202
Character of Well (Completed as Oil, Gas or Dry Hole): Dry Hole
Date Well Completed 9-2-82
Application for plugging filed 9-10-82
Plugging commenced 9-2-82
Plugging completed 9-2-82
Reason for abandonment of well or producing formation Dry Hole

Was permission obtained from the Conservation Division or it's
Agent's before plugging was commenced? Yes

Name of Conservation Agent who supervised plugging of this well Paul Luthi

Producing formation _____ Depth to top _____ bottom T.D. 4920'

Show depth and thickness of all water, oil and gas formations.

OIL, GAS OR WATER RECORDS Casing Record

Formation	Content	From	To	Size	Put in	Pulled Out
		0'	509'	8-5/8"	502.47'	None

Describe in detail the manner in which the well was plugged, indicating where the mud fluid was placed and the method or methods used in introducing it into the hold. If cement or other plugs were used, state the character of same and depth placed, from _____ feet to _____ feet for each plug set.

Plugged with 70 sacks 50-50 Pozmix Cement,
4% Gel, 3% CaCl₂ at 900'; 40 sacks cement
at 510'; solid bridge plug and wooden plug
and 10 sacks cement at 40'; circulated 10
sacks cement in rat hole.

(If additional description is necessary, use BACK of this sheet)

Name of Plugging Contractor Allied Cementing Co.

STATE OF KANSAS COUNTY OF SEDGWICK, ss.


John D. Knightley Agent (employee of owner) or (owner or operator) of the above-described well, being first duly sworn on oath, says: That I have knowledge of the facts, statements, and matters herein contained and the log of the above-described well as filed and that the same are true and correct. So help me God.

RECEIVED
STATE CORPORATION COMMISSION

(Signature) [Signature]
221 S. Broadway, Wichita, KS 67202
(Address)

SEP 14 1982

SUBSCRIBED AND SWORN TO before me this 10th day of September, 19 82
Wichita, Kansas

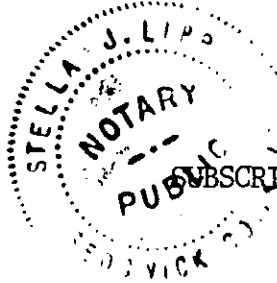

[Signature]
Notary Public.

My Commission expires: March 12, 1983