

STATE OF KANSAS
STATE CORPORATION COMMISSION

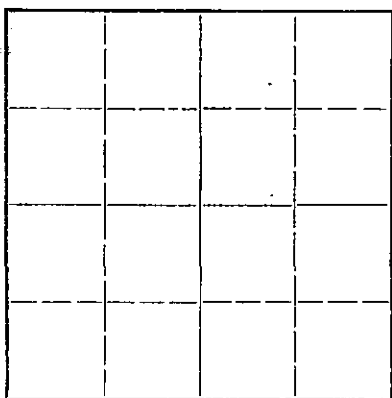
WELL PLUGGING RECORD

OR

FORMATION PLUGGING RECORD

Strike out upper line
when reporting plug-
ging off formations.Give All Information Completely
Make Required Affidavit
Mail or Deliver Report to:
Conservation Division
State Corporation Commission
500 Bitting Building
Wichita, Kansas

NORTH

Locate well correctly on above
Section Plat

Comanche County. Sec. 10 Twp. 31S Rge. 17 (W)
Location as "NE $\frac{1}{4}$ NW $\frac{1}{4}$ SW $\frac{1}{4}$ " or footage from lines. C. NW NE
Lease Owner. J. M. Huber Corporation
Lease Name. Ferrin Well No. 1
Office Address. 302 Petroleum Bldg., Wichita 2, Kansas.
Character of Well (completed as Oil, Gas or Dry Hole). Dry
Date well completed. 7/30 19 47
Application for plugging filed. 7/30 19 47
Application for plugging approved. 7/30 19 47
Plugging commenced. 7/30 19 47
Plugging completed. 7/30 19 47
Reason for abandonment of well or producing formation. Dry

If a producing well is abandoned, date of last production. 19
Was permission obtained from the Conservation Division or its agents before plugging was com-
menced? Yes

Name of Conservation Agent who supervised plugging of this well. H. W. Kerr
Producing formation. Depth to top. Bottom. Total Depth of Well. 5595 $\frac{1}{2}$ Feet
Show depth and thickness of all water, oil and gas formations.

OIL, GAS OR WATER RECORDS

CASING RECORD

Formation	Content	From	To	Size	Put In	Pulled Out
				10" 3/4"	880	None

Describe in detail the manner in which the well was plugged, indicating where the mud fluid was placed and the method or methods used in introducing it into the hold. If cement or other plugs were used, state the character of same and depth placed, from.....feet to
.....feet for each plug set.

Mud 5595 $\frac{1}{2}$ ' to 300'
Cement plug 300' to 250'
Mud 250' to 20'
Cement plug 20' to 5'

(If additional description is necessary, use BACK of this sheet)

Correspondence regarding this well should be addressed to Mr. E. A. Huffman, J. M. Huber Corporation
Address 302 Petroleum Bldg., Wichita, Kansas.

STATE OF Kansas, COUNTY OF Sedgwick, ss.

Edward A. Huffman (employee of owner) or (owner) of the above-described well,
being first duly sworn on oath, says: That I have knowledge of the facts, statements, and matters herein contained and the log of the above-
described well as filed and that the same are true and correct. So help me God.

(Signature)

Edward A. Huffman

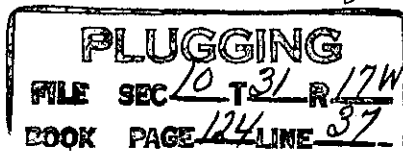
302 Petroleum Bldg., Wichita 2, Kansas.

SUBSCRIBED AND SWORN to before me this 5th day of August, 19 47.

My commission expires June 7, 1950

21-6858-RS

2-47-6M

Annetta Tyrell
Notary Public.

FARM NAME: Ferrin No. 1
COMPANY: J.N.HUBER CORPORATION
CONTRACTOR: J.N.HUBER CORPORATION

LOCATION: C NW NE Sec. 10-31S-17W,
Comanche County, Kansas.

COMMENCED: 6/25/47
COMPLETED: 7-30-47

PRODUCTION: Dry & abandoned

CASING USED: 10" @ 830'.

Shale & sand	70	Cherty lime & chat w/shale strks	5055
Sand, gyp, shells	400	Cherty lime	5060
Red bed & shells	680	Chat lime & shale	5099
Red bed & gyp shells	880	Chat lime	5116
Red bed - shells	980	Chat shale	5145
Red bed shale & shells	1165	Lime & chert	5179
Salt shale & shells	1300	Lime & chat	5204
Shale & shells	1600	Chert- chat	5226
Shale & shells & salt beds	1865	Lime & chert	5260
Lime & shale	2050	Lime	5280
Shale & lime streaks	2220	Lime broken	5295
Lime & shale streaks	2385	Lime	5298
Lime & shale	2445	Lime cherty	5347
Lime & shale streaks	2490	Lime & chert	5370
Shale & shells	2515	Lime & shale	5399
Lime & shale	2630	Lime	5434
Lime - shale streaks	2705	Lime chert	5467
Shale & lime streaks	2740	Sandy dolo - sand & shale	5505
Shale	2805	Sand & shale	5512
Lime, shale streaks	2865	Sandy shale - shells	5555
Shale & lime	2915	Shale & sand	5563
Lime & shale	2990	Sand & lime	5566
Lime, shale streaks	3150	Arbuckle lime	5588
Lime & shale	3460	Lime (hard)	5595 1/2
Lime - shale streaks	3520		
Lime & shale	3650	Total Depth	5595 1/2 N.S.
Lime	3710		
Lime & shale	3755	SAMPLE TOPS:	
Broken lime	3825	Top Blaine	300
Lime soft	3866	Top Anhydrite	970
Lime	3895	Top Limestone Section	4058
Lime Broken	3960	Top Lansing	4301
Lime	4040	Top Mississippi Lime	4 5986 c
Shale & lime	4095		
Lime w/ shale streaks	4145	HDST	5017-60, open 1 hr. rec. 358'
Lime & shale	4185		mud, 2150' salt wtr.
Lime & shale streaks	4240	HDST	5086-99 open 1 hr. rec. 90'
Lime & shale	4435		mud, N.S.
Lime & shale streaks	4480	Top Viola	5267
Lime & shale	4520	HDST	5272-80 open 1 hr. rec. 25'
Lime	4530		Mud, no show.
Lime & shale	4750	Top Simpson	5462
Lime shale streaks	4785	HDST	5490-5512, open 25 min. rec.
Lime & shale	4955		12' mud. N.S.
Shale & shells	4980	Top Arbuckle	5566'
Lime	4990		D & A.
Mississippi Chat lime	5010		

STATE OF KANSAS }
COUNTY OF SEDGWICK } SS

I hereby certify that the above is a true and correct copy of the log of the Ferrin No. 1 located in the Center of the Northwest Quarter of the Northeast Quarter of Section 10, Township 31 South, Range 17 West, Comanche County, Kansas.

Edward A. Huffman
District Manager, J.N. Huber Corporation

Subscribed and sworn to before me this 8th day of August 1947.

Notary Public.

My Commission expires June 7, 1950.

