


STATE OF KANSAS
STATE CORPORATION COMMISSION

WELL PLUGGING RECORD

Give All Information Completely
Make Required Affidavit
Mail or Deliver Report to
Conservation Division
State Corporation Comm.
245 North Water
Wichita, KS 67202

NE SW Comanche County. Sec. 4 Twp. 31S Rge. 17E/W
Location as "NE/CNW 1/4 SW 1/4" or footage from lines
1980' FWL & 1980' FSL

Lease Owner Energetics, Inc.
Lease Name Kasper Well No. 23-4
Office Address 102 Inverness Terr. East, Englewood, CO 80112
Character of Well (Completed as Oil, Gas or Dry Hole) Dry Hole

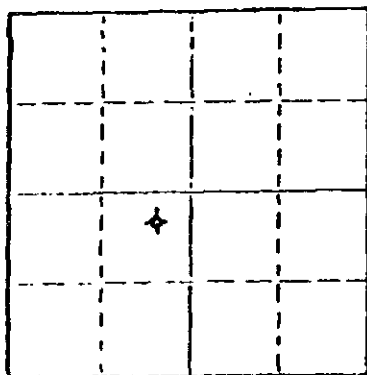

Locate well correctly on above
Section Plat

Date Well completed 19
Application for plugging filed Verbal May 26 1981
Application for plugging approved May 26 1981
Plugging commenced May 27 1981
Plugging completed May 27 1981
Reason for abandonment of well or producing formation Dry Hole

If a producing well is abandoned, date of last production 19

Was permission obtained from the Conservation Division or
its agents before plugging was commenced? Yes

Name of Conservation Agent who supervised plugging of this well Unknown
Producing formation _____ Depth to top _____ Bottom _____ Total Depth of Well _____
Show depth and thickness of all water, oil and gas formations.

OIL, GAS OR WATER RECORDS

CASING RECORD

FORMATION	CONTENT	FROM	TO	SIZE	PUT IN	PULLED OUT
see attached driller's log				5/8"	629'	None

Describe in detail the manner in which the well was plugged, indicating where the mud fluid was placed and the method or methods used in introducing it into the hold. If cement or other plugs were used, state the character of same and depth placed, from _____ feet to _____ feet for each plug set.

see attached drilling contractor's report

RECEIVED
STATE CORPORATION COMMISSION

JUN 15 1981

CONSERVATION DIVISION
Wichita, Kansas

(If additional description is necessary, use BACK of this sheet)

Name of Plugging Contractor Halliburton

STATE OF Colorado COUNTY OF Arapahoe, ss.
Lee J. Thronson (employee of owner) or (owner or operator)
of the above-described well, being first duly sworn on oath, says: That I have knowledge of the facts, statements, and matters herein contained and the log of the above-described well as filed and that the same are true and correct. So help me God.

(Signature) Lee J. Thronson

Energetics, Inc., 102 Inverness Terrace East,
(Address) Englewood, CO 80112

SUBSCRIBED AND SWORN TO before me this 9th day of June, 19 81

Pauline K. Hart
Notary Public.

My commission expires November 7, 1983

STATE OF KANSAS

15-033-20419-00-00

STATE CORPORATION COMMISSION
CONSERVATION DIVISION
200 Colorado, Derby Bldg.
Wichita, Kansas 67202

INVOICE and WELL PLUGGING AUTHORITY

June 26, 1981

INVOICE NUMBER: 5790-W

TO: Energetics, Inc.
102 Inverness Terrace East,
Englewood, Co. 80112

PLUGGING ASSESSMENT AS FOLLOWS:

T.D. 5155'
Kasper #23-4
C NE SW, Sec. 4-31S-17W
Comanche
Rine Drilling Co.

\$167.54

NOTE: We also need the following before our file is completed:


- Well Plugging Record (CP-4)
- Well Log
- Well Plugging Application (CP-1)

WELL PLUGGING AUTHORITY

Gentlemen:

This is your authority to plug the above subject well in accordance with the rules and regulations of the state corporation commission.

This authority is void after ninety (90) days from the above date.

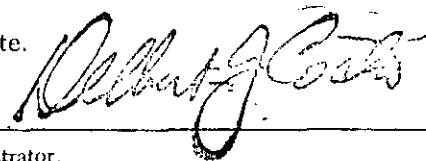

PAYABLE UPON RECEIPT

For Administrator

Mr. Maurice Leslie, R. R. #1, Nashville, KS, 67112

is hereby assigned to supervise the plugging of the above mentioned well.