

WELL PLUGGING RECORD


Give All Information Completely
Make Required Affidavit
Mail or Deliver Report to:
Conservation Division
State Corporation Commission
800 Bittling Building
Wichita, Kansas

35

Barber County, Sec. 11 Twp. 11S Rge. 15 (E) 15 (W)

Location as "NE/CNW/SW" or footage from lines C NE 1/4 NE 1/4
Lease Owner Champlin Oil & Refining Co.
Lease Name Davis Ranch Well No. 1
Office Address Box 167, Ellinwood, Kansas
Character of Well (completed as Oil, Gas or Dry Hole) Oil
Date well completed January 25 1955
Application for plugging filed January 13 1959
Application for plugging approved January 19 (Verbal) 1959
Plugging commenced January 14 1959
Plugging completed January 20 1959
Reason for abandonment of well or producing formation Non Productive

NORTH

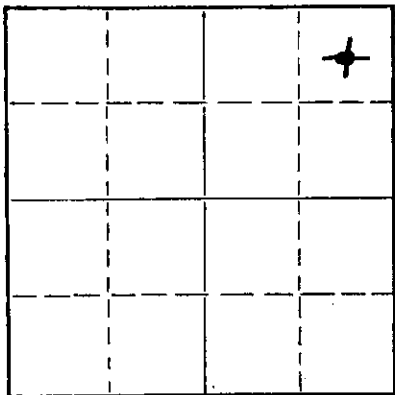

Locate well correctly on above
Section Plat

If a producing well is abandoned, date of last production Non Productive 19
Was permission obtained from the Conservation Division or its agents before plugging was commenced? Yes

Name of Conservation Agent who supervised plugging of this well W. L. LeKamp
Producing formation _____ Depth to top _____ Bottom _____ Total Depth of Well 5777 Feet
Show depth and thickness of all water, oil and gas formations. 4250 PBT

OIL, GAS OR WATER RECORDS

CASING RECORD

FORMATION	CONTENT	FROM	TO	SIZE	PUT IN	PULLED OUT
				13-3/8 OD	396	None
				5 1/2 OD	5090	3287

Describe in detail the manner in which the well was plugged, indicating where the mud fluid was placed and the method or methods used in introducing it into the hole. If cement or other plugs were used, state the character of same and depth placed, from _____ feet to _____ feet for each plug set.

Filled hole with mud from 4250' PBT to 300', set rock bridge and pumped in 30 sacks of cement then filled with mud from top of cement at 250' to 15' and set a 2' rock bridge and pumped in 10 sacks of cement filling hole to bottom of cellar.

RECEIVED
STATE CORPORATION COMMISSION
1-23-59
JAN 23 1959

(If additional description is necessary, use BACK of this sheet)

Name of Plugging Contractor Ace Pipe Pulling Co.
Address Box 304, Great Bend, Kansas

STATE OF Kansas, COUNTY OF Barton, ss.
J. W. Meyers (employee of owner) or (owner or operator) of the above-described well, being first duly sworn on oath, says: That I have knowledge of the facts, statements, and matters herein contained and the log of the above-described well as filed and that the same are true and correct. So help me God.

(Signature) *J. W. Meyers*
Box 167, Ellinwood, Kansas
(Address)

SUBSCRIBED AND SWORN to before me this 21st day of January, 19 59

M. Kenneth Stinson
Notary Public.

My commission expires 5-22-62

PLUGGING
FILE SEC 11 T 35 R 15W
BOOK PAGE 10 LINE 38

FORMATION LOG

Champlin Oil & Refining Co.

Davis Ranch #1

Located: 660' from North line, 660' from East line of the
Northeast quarter of Section 11-35S-15W, Barber County, Kansas.

	<u>FROM</u>	<u>TO</u>
Red Bed	0'	1922'
Anhydrite-Shale	1922	2167
Lime	2167	2315
Lime & Shale	2315	3852
Sand	3852	4104
Lime & Shale	4104	4280
Lime	4280	5013
Lime & Chert	5013	5042
Lime	5042	5538
Lime & Chert	5538	5554
Lime	5554	5620
Sand	5620	5677
Sand & Shale	5677	5763
Lime	5763	5777
Total Depth	5777	
Plug Back Total Depth	4250	

RECEIVED
STATE CORPORATION COMMISSION

JAN 14 1959
1-14-59
CONSERVATION DIVISION
Wichita, Kansas

PLUGGING

FILE SEC <u>11</u> T. <u>35</u> R. <u>15W</u>
BOOK PAGE <u>10</u> LINE <u>30</u>