


STATE OF KANSAS
STATE CORPORATION COMMISSION

WELL PLUGGING RECORD

Give All Information Completely
Make Required Affidavit
Mail or Deliver Report to
Conservation Division
State Corporation Comm.
245 North Water
Wichita, KS 67202

Barber County. Sec. 3 Twp. 35S Rge. 14 E/W
Location as "NE/CNW $\frac{1}{4}$ /SW $\frac{1}{4}$ " or footage from lines
C SW SE NW

Lease Owner Cities Service Oil Co.
Lease Name STERNBERGER "A" Well No. 1
Office Address 700 Sutton Place, Wichita Kansas 67202
Character of Well (Completed as Oil, Gas or Dry Hole)
Dry Hole

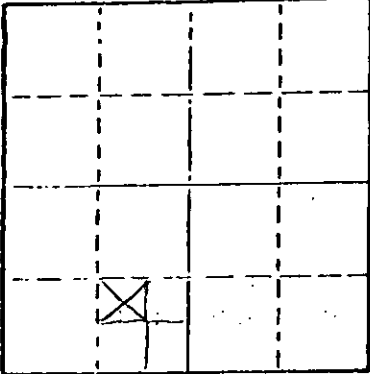

Locate well correctly on above
Section Plot

Date Well completed August 10, 1976 1976
Application for plugging filed (verbally) Aug. 10 1976
Application for plugging approved (verbally) Aug. 10 1976
Plugging commenced August 10 1976
Plugging completed August 10 1976
Reason for abandonment of well or producing formation
No commercial quantity of oil or gas encountered.
If a producing well is abandoned, date of last production
19

Was permission obtained from the Conservation Division or
its agents before plugging was commenced? Yes

Name of Conservation Agent who supervised plugging of this well G. Russell Biberstein
Producing formation _____ Depth to top _____ Bottom _____ Total Depth of Well _____
Show depth and thickness of all water, oil and gas formations.

OIL, GAS OR WATER RECORDS

CASING RECORD

FORMATION	CONTENT	FROM	TO	SIZE	PUT IN	PULLED OUT

Describe in detail the manner in which the well was plugged, indicating where the mud fluid
was placed and the method or methods used in introducing it into the hold. If cement or other
plugs were used, state the character of same and depth placed, from _____ feet to
_____ feet for each plug set.

RECEIVED
STATE CORPORATION COMMISSION

1st Plug set @ 300' with 35 sx.
2nd Plug set @ 40' with 15 sx

AUG 13 1976
8-13-76
CONSERVATION DIVISION
Wichita, Kansas

Plug was down at 9:30 p.m. August 10, 1976
STATE PLUGGER: G. Russell Biberstein

(If additional description is necessary, use BACK of this sheet)

Name of Plugging Contractor _____

STATE OF Kansas COUNTY OF Sedgwick SS.
Jerry A. Langrehr-Exec. V.P.

(employee of owner) or (owner or operator) of the above-described
well, being first duly sworn on oath, says: That I have knowledge of the facts, statements, and matters herein contained and the log of the
above-described well as filed and that the same are true and correct. So help me God.

(Signature) Jerry A. Langrehr

801 Union Center

(Address) _____ 19 76

12th


day of August

19 76

July 21, 1979

Sandra Richman

Notary Public.

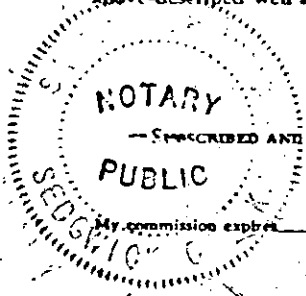

CONTRACTOR'S WELL LOG

OPERATOR: Cities Service Oil Co.
 CONTRACTOR: Abercrombie Drilling, Inc.
 WELL NAME: STERNBERGER "A" #1
 LOCATION: C SW SE NW, Section 3-35S-14W
 Barber County, Kansas
 SPUD DATE: July 26, 1976
 COMPLETION DATE: August 10, 1976

0 20
 20 40
 40 102
 102 910
 910 1211
 1211 2066
 2066 2076
 2070 2235
 2235 2495
 2495 3424
 3424 4004
 4004 4405
 4405 4950
 4950

Red Bed
 Gypsum
 Sand
 Red Bed & Shells
 Shale & Sand
 Shale
 Lime & Shale
 Shale & Shells
 Shale
 Lime & Shale
 Shale & Lime
 Lime & Shale
 Lime
 Rotary Total Depth

RECEIVED
 STATE CORPORATION COMMISSION
 AUG 13 1976
 8-13-76
 CONSERVATION DIVISION
 Wichita, Kansas

Spud on July 26, 1976. Drilled 445' 12 1/4" Hole. Ratholed ahead - 1211'. Set 439' 8 5/8" Surface Casing. Cemented with 350 sx. cement. Cement did circulate. Plug down at 9:40 p.m. 7-26-76.

RTD 4950', 1st plug at 300' with 35 sx., 2nd plug at 40' with 15 sx., filled rathole with 5 sx. Plugged at 9:30 p.m. - 8-10-76. State plugger - G. Russell Biberstein

STATE OF KANSAS)
) SS
 COUNTY OF SEDGWICK)

Jerry A. Langrehr, Executive Vice President of Abercrombie Drilling, Inc, does hereby state that the above and foregoing is a true and correct copy fo the log of the STERNBERGER "A" #1, C SW SE NW, Section 3-35S-14W, Barber County, Kansas.

ABERCROMBIE DRILLING, INC.

By: Jerry A. Langrehr
 Jerry A. Langrehr, Exec. V.P.

Subscribed and sworn to before me, a Notary Public, in and for the aforesaid county and state as of this 12th day of August, 1976.



Sandra Richman
 Sandra Richman, Notary Public

My Commission Expires: July 21, 1979.

COPY