


STATE OF KANSAS
STATE CORPORATION COMMISSION

Form CP-4

Give All Information Completely
Make Required Affidavit
Mail or Deliver Report to:
Conservation Division
State Corporation Commission
212 No. Market
Wichita, Kansas 67202

WELL PLUGGING RECORD

Barber County, Sec 2 Twp 35 Rge 14 (E) (W) X
Location as "NE/CNW/SE/SW" or footage from lines NW NW NW
Lease Owner Midwestern Supply Co Inc
Lease Name MCLZ Well No. 1
Office Address 207 Brown Blvd Wichita Kansas 67202
Character of Well (completed as Oil, Gas or Dry Hole) Gas
Date well completed _____ 19____
Application for plugging filed 5-17 1973
Application for plugging approved 5-18 1973
Plugging commenced 5-21 1973
Plugging completed 5-31 1973
Reason for abandonment of well or producing formation _____

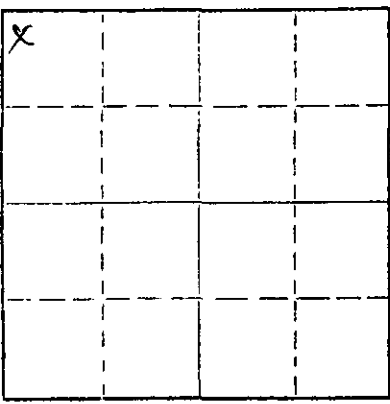

Locate well correctly on above
Section Plat

Name of Conservation Agent who supervised plugging of this well Russell Biberstein
Producing formation Mississippie Depth to top _____ Bottom _____ Total Depth of Well 5650 Feet
Show depth and thickness of all water, oil and gas formations.

OIL, GAS OR WATER RECORDS

CASING RECORD

FORMATION	CONTENT	FROM	TO	SIZE	PUT IN	PULLED OUT
				4 1/2	4920	3950
				13	170	None

RECEIVED
STATE CORPORATION COMMISSION
JUN 22 1973
6-22-73
CONSERVATION DIVISION
Wichita, Kansas

Describe in detail the manner in which the well was plugged, indicating where the mud fluid was placed and the method or methods used in introducing it into the hole. If cement or other plugs were used, state the character of same and depth placed, from _____ feet to _____ feet for each plug set.

Well was Plugged Back to 4920 and 4 1/2" set there.
Shoe Joint Not drilled up.
Sand up to 4800 From 4990.
Dump four sacks cement From 4800 to 4760.
Ripped pipe at 4300 4200 4050 and 3950.
Pulled and lugged down 4 1/2"
~~Back~~ Build at 175. Rock from 175 to 165.
Dump 45 sacks of cement from 165 to 100.
Mud From 100 to 40.
Rock From 40 to 30.
20 Sacks of cement From 30 to surface.

(If additional description is necessary, use BACK of this sheet)

Name of Plugging Contractor C. Park Corp.
Address Box 187 Medicine Lodge Kansas

STATE OF Kansas COUNTY OF Sedgewick ss.
Midwestern Supply (employee-owner) or (owner or operator) of the above-described well, being first duly sworn on oath, says: That I have knowledge of the facts, statements, and matters herein contained and the log of the above-described well as filed and that the same are true and correct. So help me God.

(Signature) Robert M. Chumbley
207 Brown Blvd Wichita KS 67202
(Address)

SUBSCRIBED AND SWORN to before me this 21 day of June, 1973

My commission expires Nov. 29, 1975 Margie Hall Notary Public.

15-007-0027-00-8
 WELL LOG BUREAU—KANSAS GEOLOGICAL SOCIETY
 503 East Murdock, Wichita, Kansas

COPY


Company- WILLIAM GRUENERWALD ET AL
 Farm- C. Molz No. 1

SEC. 8 T. 35 R. 11W
 NW NW NW

Total Depth. 5658'
 Comm. 6-18-56 Comp. 7-21-56
 Shot or Treated.
 Contractor. Patton Drlg. Co.
 Issued. 2-2-57

County Barber

KANSAS

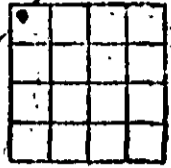

CASINO:
 13 3/8" 187' w/250 sx oem.

Elevation. 1491' RB

Production. Dry

Figures indicate Bottom of Formations.

river sand	20
red shale	187
shale	1110
sand shale anhydrite	1800
lime-shale	4279
lime	4653
lime-shale	4760
lime	4817
lime-shale	4822
lime cherty	4908
lime	4920
lime cherty	4927
lime	5018
lime-shale	5256
lime	5261
lime cherty	5274
lime	5374
lime cherty	5405
lime	5414
lime-shale	5458
shale sdy	5597
lime-shale	5607
lime	5662 RTD
lime	5658
Total Depth	

TOPS: Scout	
Elgin	3755
Heebner	3960
Toronto	3985
Lansing	4146
Det Mississippi	4797
Chat Mississippi	4822
Kinderhook	5124
Chat	5208
Maquoketa	5252
Viola	5276
Simpson	5428
Artuckle	5607

RECEIVED
 STATE CORPORATION COMMISSION
 MAR 5 1973
 3-5-73
 CONSERVATION DIVISION
 Wichita, Kansas