


15-007-20107-0000

STATE OF KANSAS  
STATE CORPORATION COMMISSION

WELL PLUGGING RECORD

Give All Information Completely  
Make Required Affidavit  
Mail or Deliver Report to:  
Conservation Division  
State Corporation Commission  
212 No. Market  
Wichita, Kansas

NORTH

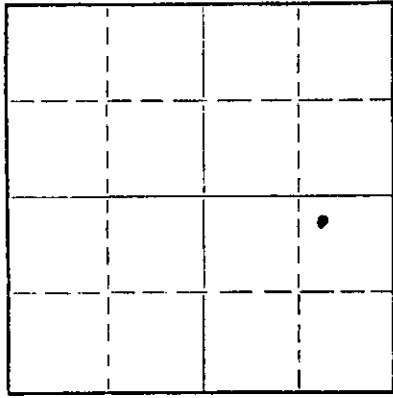

Locate well correctly on above  
Section Plat

Barber County, Sec. 8, Twp. 35S, Rge. (E) 14 (W)  
Location as "NE/CNW&SW" or footage from lines 990' FEL 2310' FSL  
Lease Owner Shenandoah Oil Corporation  
Lease Name Molz. Well No. 1  
Office Address 1018 Commerce Bldg., Ft. Worth, Texas  
Character of Well (completed as Oil, Gas or Dry Hole) Gas Well  
Date well completed - 19  
Application for plugging filed January 14, 1970  
Application for plugging approved January 16, 1970  
Plugging commenced February 16, 1970  
Plugging completed February 25, 1970  
Reason for abandonment of well or producing formation  
Gas - TSTM

If a producing well is abandoned, date of last production - 19  
Was permission obtained from the Conservation Division or its agents before plugging was commenced? Yes

Name of Conservation Agent who supervised plugging of this well Herman Justus, Box 71, Nickerson, Kansas  
Producing formation \_\_\_\_\_ Depth to top \_\_\_\_\_ Bottom \_\_\_\_\_ Total Depth of Well 4962 Feet  
Show depth and thickness of all water, oil and gas formations.

OIL, GAS OR WATER RECORDS

CASING RECORD

FORMATION	CONTENT	FROM	TO	SIZE	PUT IN	PULLED OUT
				13-3/8"	110'	None
				8-5/8"	909'	None
				4-1/2"	4962'	4049.54'

Describe in detail the manner in which the well was plugged, indicating where the mud fluid was placed and the method or methods used in introducing it into the hole. If cement or other plugs were used, state the character of same and depth placed, from \_\_\_\_\_ feet to \_\_\_\_\_ feet for each plug set.

A 10 sack cement plug was pumped to 4650 feet with mud laden fluid. Pipe was shot free at 4040 feet and pulled. A 100 sack cement plug was pumped from 300 feet to surface.

RECEIVED  
STATE CORPORATION COMMISSION  
3-18-70  
MAR 18 1970  
CONSERVATION DIVISION  
Wichita, Kansas

(If additional description is necessary, use BACK of this sheet)  
Name of Plugging Contractor Clyde A. Reeves & Son, Inc.  
Address P. O. Box 94204, Oklahoma City, Oklahoma

STATE OF Texas COUNTY OF Tarrant, ss.  
R. L. Nabbefeld (employee of owner) or (owner or operator) of the above-described well, being first duly sworn on oath, says: That I have knowledge of the facts, statements, and matters herein contained and the log of the above-described well as filed and that the same are true and correct. So help me God.

(Signature) *R. L. Nabbefeld*  
1500 Commerce Bldg., Fort Worth, Texas 76102  
(Address)

SUBSCRIBED AND SWORN TO before me this 12th day of March, 1970

*Connie L. Bulmer*  
Notary Public.