


STATE OF KANSAS  
STATE CORPORATION COMMISSION

WELL PLUGGING RECORD

Give All Information Completely  
Make Required Affidavit  
Mail or Deliver Report to  
Conservation Division  
State Corporation Comm.  
245 North Water  
Wichita, KS 67202

Barber County, Sec. 16 Twp. 35S Rge. 14W E/W  
Location as "NE/CNW/SW" or footage from lines C

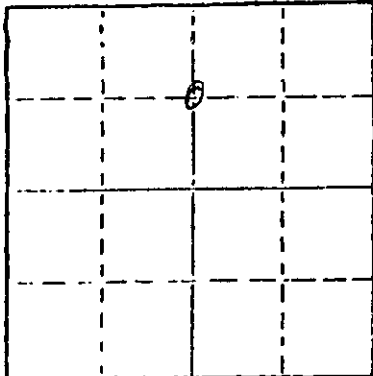

Locate well correctly on above  
Section Plat

Lease Owner Clark Exploration  
Lease Name Wolgammott Well No. 1  
Office Address Box 245, Hardtner, Ks 67057  
Character of Well (Completed as Oil, Gas or Dry Hole) Dry  
Date Well completed 11-2 1981  
Application for plugging filed 11-1 1981  
Application for plugging approved 11-1 1981  
Plugging commenced 11-2 1981  
Plugging completed 11-2 1981  
Reason for abandonment of well or producing formation Dry

If a producing well is abandoned, date of last production 19  

Was permission obtained from the Conservation Division or its agents before plugging was commenced? Yes

Name of Conservation Agent who supervised plugging of this well Maurice Leslie  
Producing formation                      Depth to top                      Bottom                      Total Depth of Well 4880  
Show depth and thickness of all water, oil and gas formations.

OIL, GAS OR WATER RECORDS

CASING RECORD

FORMATION	CONTENT	FROM	TO	SIZE	PUT IN	PULLED OUT
		0	348	8 5/8		

Describe in detail the manner in which the well was plugged, indicating where the mud fluid was placed and the method or methods used in introducing it into the hold. If cement or other plugs were used, state the character of same and depth placed, from                      feet to                      feet for each plug set.

Plugged:  
60 sacks @ 1470  
40 sacks @ 320  
10 Sacks @ 40  
10 sacks in rathole; 5 sacks in mousehole.  
Completed 11-2-81 @ 12:00 M  
Cemented by Allied Cementing

RECEIVED  
STATE CORPORATION COMMISSION  
APR 2 1982  
CONSERVATION DIVISION  
WICHITA, KANSAS

(If additional description is necessary, use BACK of this sheet)

Name of Plugging Contractor DaMac Drilling Inc.  
Box 1164, Great Bend, Ks 67530

STATE OF Kansas COUNTY OF Barton, ss.  
Martha J. McKown (employee of owner) or (owner or operator)  
of the above-described well, being first duly sworn on oath, says: That I have knowledge of the facts, statements, and matters herein contained and the log of the above-described well as filed and that the same are true and correct. So help me God.

(Signature) Martha J. McKown  
Box 1164, Great Bend, Ks. 67530  
(Address)

SUBSCRIBED AND SWORN TO before me this 2nd day of Nov., 19 81

VADA L SULLIVAN  
Barton County, Kansas  
My Appt. Exp. 1-30-84

Vada L. Sullivan  
Notary Public.

My commission expires

15-007-21314-0000

# WELL LOG

COMPANY Clark Exploration

SEC. 16 T. 35S R. 14W

FARM Wolgamott NO. 1

LOC. C


TOTAL DEPTH 4880 RTD

COUNTY Barber County, Ks

COMM. 10-23-81 COMP. 11-2-81

CONTRACTOR DaMac Drilling Inc.

CASING 8 5/8 set @ 348

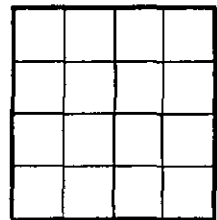

ELEVATION

PRODUCTION

P&A

FIGURES INDICATE BOTTOM OF FORMATIONS

Surface Sand	0	1141
Shale	1141	2249
Lime, Shale	2249	4880 RTD

RECEIVED  
 STATE CORPORATION COMMISSION  
 4-2-82  
 APR -2 1982  
 CONSERVATION DIVISION  
 Wichita, Kansas

State of Kansas }  
 County of Barton } ss

I, Martha J. McKown of DaMac Drilling Inc.

upon oath state the above and foregoing is a true and correct copy of the log of the Wolgamott No. 1 well.



Martha J. McKown

Subscribed and sworn to before me this 2nd day of Nov. 19 81

My Commission Expires: \_\_\_\_\_

Vada L. Sullivan

NOTARY PUBLIC