


15-007-00371-0001

STATE OF KANSAS
STATE CORPORATION COMMISSION

Form CP-4

Give All Information Completely
Make Required Affidavit
Mail or Deliver Report to:
Conservation Division
State Corporation Commission
P. O. Box 17027
Wichita, Kansas 67217
NORTH

WELL PLUGGING RECORD

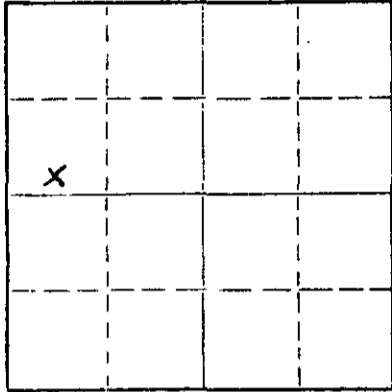

Locate well correctly on above
Section Plat

Barber County, Sec. 16 Twp. 35 Rge. 14 (E)W (W)
Location as "NE/CNW/SW" or footage from lines S/2 SW NW
Lease Owner J. M. Huber Corporation
Lease Name Walgamott Well No. 1
Office Address 2000 W. Loop South, Houston, Texas 77027
Character of Well (completed as Oil, Gas or Dry Hole) Gas
Date well completed March 8 1957
Application for plugging filed June 1 1973
Application for plugging approved June 7 1973
Plugging commenced June 25 1973
Plugging completed June 27 1973
Reason for abandonment of well or producing formation Depleted

If a producing well is abandoned, date of last production February 1973
Was permission obtained from the Conservation Division or its agents before plugging was commenced? Yes

Name of Conservation Agent who supervised plugging of this well Russell Biberstein
Producing formation Cherokee Depth to top 4865 Bottom 4869 Total Depth of Well 5725 Feet
Show depth and thickness of all water, oil and gas formations.

OIL, GAS OR WATER RECORDS

CASING RECORD

FORMATION	CONTENT	FROM	TO	SIZE	PUT IN	PULLED OUT
Cherokee	Gas	4865	4869	5-1/2	4968	3550

Describe in detail the manner in which the well was plugged, indicating where the mud fluid was placed and the method or methods used in introducing it into the hole. If cement or other plugs were used, state the character of same and depth placed, from _____ feet to _____ feet for each plug set.

Moved in Lillard casing pullers. Pulled 4825' 5/8" rods & 4875' 2-3/8" tubing.
Spotted 25 sx cement @ 4470'. Shot casing free @ 3535'. Recovered 109 its 5-1/2" casing (3550'). Set 100 sx cement plug from 3337' to 3237'. Set 15 sx cement plug from 18' to 3'.
Welded steel plate on top of surface casing.

RECEIVED
STATE CORPORATION COMMISSION
JUL 30 1973
CONSERVATION DIVISION
Wichita, Kansas

(If additional description is necessary, use BACK of this sheet)

Name of Plugging Contractor Lillard Casing Pullers, Inc.
Address P. O. Box 962, Woodward, Oklahoma 73801

STATE OF TEXAS, COUNTY OF HARRIS, ss.
J. M. Huber Corporation (employee of owner) or (owner or operator) of the above-described well, being first duly sworn on oath, says: That I have knowledge of the facts, statements, and matters herein contained and the log of the above-described well as filed and that the same are true and correct. So help me God.

(Signature) Paul M. Walker Paul M. Walker
2000 West Loop South, Houston, Texas 77027
(Address)

SUBSCRIBED AND SWORN TO before me this 26th day of July, 1973

My commission expires _____

Hazel P. Shaller
Notary Public.
HAZEL P. SHALLER
Notary Public in and for Harris County, Texas
My Commission Expires June 1, 1975
467 - 24 - 5250