


WELL PLUGGING RECORD

Give All Information Completely
Make Required Affidavit
Mail or Deliver Report to:
Conservation Division
State Corporation Commission
800 Biting Building
Wichita, Kansas

Barber County, Sec. 12 Twp. 35 Rge. (E) 14 (W)
Location as "NE/CNW/SW" or footage from lines NW NW SE
Lease Owner City Products Corporation
Lease Name Sternberger Well No. #1
Office Address 33 South Clark Street, Chicago, Illinois
Character of Well (completed as Oil, Gas or Dry Hole) Dry Hole
Date well completed May 26 19 54
Application for plugging filed May 28 19 54
Application for plugging approved May 28 19 54
Plugging commenced May 29 19 54
Plugging completed May 29 19 54
Reason for abandonment of well or producing formation Dry Hole

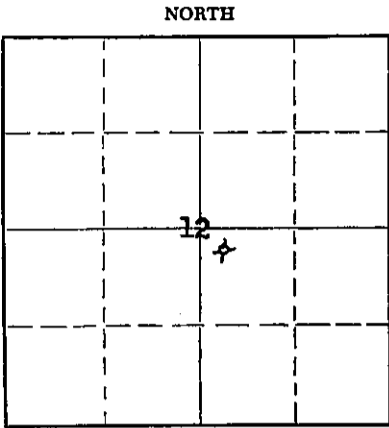

Locate well correctly on above Section Plat

If a producing well is abandoned, date of last production 19
Was permission obtained from the Conservation Division or its agents before plugging was commenced? Yes

Name of Conservation Agent who supervised plugging of this well Mr. M. A. Rives, Box 8, Pratt, Kansas
Producing formation Depth to top Bottom Total Depth of Well 5737 Feet
Show depth and thickness of all water, oil and gas formations.

OIL, GAS OR WATER RECORDS

CASING RECORD

FORMATION	CONTENT	FROM	TO	SIZE	PUT IN	PULLED OUT

Describe in detail the manner in which the well was plugged, indicating where the mud fluid was placed and the method or methods used in introducing it into the hole. If cement or other plugs were used, state the character of same and depth placed, from feet to feet for each plug set.

Packed with sand from 4912 to 4842; put in 5 sax cement on top of sand at 4842; shot off pipe at 4340; shot pipe off second time at 4235 - Filled hole with mud to 325' of top; dumped 35 sacks cement; filled hole with mud to 20' from top; filled hole to surface with 15 sax cement; capped hole with cement.

(If additional description is necessary, use BACK of this sheet)
Name of Plugging Contractor West Pipe Supply Company (Supt. E. E. O'Brien)
Address Chase, Kansas

STATE OF KANSAS, COUNTY OF SEDGWICK, ss.
Lee Poulsen (employee of owner) or (owner) of the above-described well, being first duly sworn on oath, says: That I have knowledge of the facts, statements, and matters herein contained and the log of the above-described well as filed and that the same are true and correct. So help me God.

(Signature) Lee Poulsen
320 Union National Bank Bldg., Wichita, Kansas
(Address)

SUBSCRIBED AND SWORN TO before me this 9th day of June, 19 54

My commission expires March 7, 1956

RECEIVED
STATE CORPORATION COMMISSION
6-10-54
JUN 10 1954
Notary Public.

PLUGGING
FILE SEC 12 T 35 R 14 W
BOOK PAGE 37 LINE 1

CONSERVATION DIVISION
Wichita, Kansas

D R I L L E R S L O G

Owner: City Products Corporation

Re: STERNBERGER #1
NW NW SE Section 12-358-14W
Barber County, Kansas

Operator &
Contractor: W. J. Coppinger

Casing Record:
Set 13-3/8" @ 332' W/250 sacks posmix
and 225 sacks cement
Set 5-1/2" @ 5040' W/150 sacks cement

Red Clay & Sand	90
Red Bed	215
Red Bed & Sand	260
Red Bed & Shells	340
Red Bed	900
Shale & Shells	1500
Salt	1535
Shale & Lime	1820
Anhydrite	1850
Shale & Lime	2304
Shale & Broken Lime	2405
Lime & Shale	3625
Shale & Shells	3725
Shale & Lime	3750
Shale	3800
Shale & Lime	3955
Shale	4030
Shale & Lime	4262
Lime	4360
Lime & Shale	4405
Lime	4465
Lime & Shale	4510
Lime	4665
Lime & Shale	4790
Lime	4860
Lime & Shale & Sand	4898
Chert	4905
Lime	4910
Lime & Shale	4935
Lime	4950
Cherty Lime	4980
Lime	5040
Lime & Shale	5365
Lime	5430
Cherty Lime & Shale	5450
Cherty Lime	5510
Shale, Lime & Sand	5526
Sand & Shale	5570
Shale	5590
Shale & Lime & Sand	5620
Sand & Shale	5675
Sand, Lime & Shale	5695
Lime & Shale	5737
Rotary Total Depth	5737

Tops

<u>Sample Analysis</u>		<u>Electrical Log</u>
Elgin Sand	3836	3836
Douglas Sand	4140	4140
Lans.-Kans.City	4231	4228
Miss. Chert	4898	4900
Miss. Dolomite	4916	4911
Kinderhook	5094	5096
Kinderhook Dolo.	5129	5129
Kinderhook Lime	5191	5194
Chattanooga	5281	5277
Maquoketa	5326	5322
Viola	5366	5370
Simpson Shale	5479	5482
Simpson Dolomite	5483	5486
Simpson Sand	5521	5518
	to	to
	5538	5533
Arbuckle	5677	5680
Rotary Total Depth	5737	5734

Commenced: April 5, 1954
Completed: May 5, 1954
Elevation: 1617 R.B.
1614 D.F.
1607 G.L.

PLUGGING
FILE SEC 12-35-R 4W
BOOK PAGE 57 LINE 1

STATE OF KANSAS)
COUNTY OF SEDGWICK) SS:

I, the undersigned, being duly sworn on oath, state that the above statement and log is a true record and log of the well drilled at the location above described.

Lee Paulsen

and sworn to before me this 13 day of May, 1954.

My commission expires: March 7, 1956

Wayne Broadus
Notary Public



RECEIVED
STATE CORPORATION COMMISSION
5-15-54
MAY 15 1954

Corp. Comm