


Give All Information Completely
Make Required Affidavit
Mail or Deliver Report to:
Conservation Division
State Corporation Commission
212 No. Market
Wichita, Kansas

WELL PLUGGING RECORD

Barber County, Sec. 14 Twp. 35S Rge. XXXX (E) 14(W)

Location as "NE/CNW/SW" or footage from lines NE SW NE
Lease Owner Western Oil Fields, Inc.
Lease Name Sternberger Well No. 6
Office Address 1800 Empire Life Bldg., Dallas, Tex. 75201
Character of Well (completed as Oil, Gas or Dry Hole) Dry hole
Date well completed 1/7 1970
Application for plugging filed 1/7 1970
Application for plugging approved 1/7 1970
Plugging commenced 1/8 1970
Plugging completed 1/8 1970
Reason for abandonment of well or producing formation Dry hole

NORTH

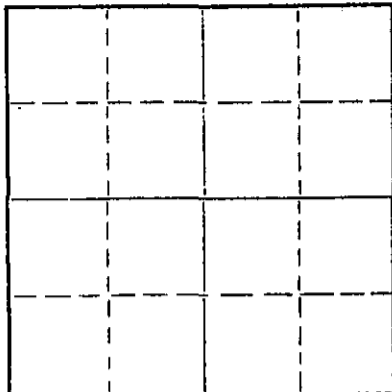

Locate well correctly on above
Section Plat

If a producing well is abandoned, date of last production None 19
Was permission obtained from the Conservation Division or its agents before plugging was commenced? Yes

Name of Conservation Agent who supervised plugging of this well G. Russel Biberstein
Producing formation None Depth to top - Bottom - Total Depth of Well 4950 Feet
Show depth and thickness of all water, oil and gas formations.

OIL, GAS OR WATER RECORDS

CASING RECORD

FORMATION	CONTENT	FROM	TO	SIZE	PUT IN	PULLED OUT
Cherokee Sand	Show gas	4852	4868	8 5/8"	418'	None
Mississippi Chert	Show gas	4872	4950			

Describe in detail the manner in which the well was plugged, indicating where the mud fluid was placed and the method or methods used in introducing it into the hole. If cement or other plugs were used, state the character of same and depth placed, from feet to feet for each plug set.

Hole full of drilling mud
1st plug 25 sacks cement @250'
2nd plug 10 sacks cement @40'
3rd plug 5 sacks at surface, casing cut off @flow depth
2 sacks cement in rathole

RECEIVED
STATE CORPORATION COMMISSION
FEB 9 1970
CONSERVATION DIVISION
Wichita, Kansas

(If additional description is necessary, use BACK of this sheet)
Name of Plugging Contractor D. R. Lauck Drilling Co. Inc.
Address 301 So. Broadway, Wichita, Kansas

STATE OF Texas, COUNTY OF Dallas, ss.
Melvin F. Endicott (employee of owner) or (owner or operator) of the above-described well, being first duly sworn on oath, says: That I have knowledge of the facts, statements, and matters herein contained and the log of the above-described well as filed and that the same are true and correct. So help me God.

(Signature) Melvin F. Endicott
1800 Empire Life Bldg Dallas Texas
(Address)

SUBSCRIBED AND SWORN TO before me this 5th day of February, 1970.

My commission expires June 1, 1971

Dolores May Withrow
Notary Public.

15-007-20138-0000

Western Oil Fields

(Lauck Drilling Company - Contractor)

#6 Sternberger

NE SW NE 14-35S-14W
Barber County, Kansas

Commenced: December 20, 1969

Completed: January 8, 1970

Casing Record: 418' 8-5/8" Cemented with 300 sacks Cement,
2% Gel, 3% Calcium Chloride.

Elevation: GL 1521; DF 1523; KB 1525.

Drillers Log

Surface Clay & Shale	120
Red Bed	545
Shale	697
Red Bed & Shale	1070
Shale	1190
Shale & Shells	1815
Lime	1923
Lime & Shale	3560
Shale & Lime	3690
Shale & Shells	3980
Lime & Shale	4225
Lime	4910
Miss. Chert	4920
Lime & Chert	4940
Lime	4950 RTD

RECEIVED
STATE CORPORATION COMMISSION
11-24-70
FEB 24 1970
CONSERVATION DIVISION
Wichita, Kansas