

CARD MUST BE TYPED

State of Kansas
NOTICE OF INTENTION TO DRILL CORRECTION 10-1985 CARD MUST BE SIGNED
(see rules on reverse side)

Starting Date: October 25, 1984
month day year

API Number 15- 007-21,944-0000

OPERATOR: License # 5601
Name Associated Petroleum Consultants, Inc.

125' W of C SW SE 1 Sec. 1 Twp. 35 S, Rge. 15 East
(location) West

Address Suite 600 - One Main Place
City/State/Zip Wichita, Kansas 67202
Contact Person Phyllis Buchanan
Phone (316) 265-9385

660' Ft North from Southeast Corner of Section
2105 Ft West from Southeast Corner of Section
(Note: Locate well on Section Plat on reverse side)

CONTRACTOR: License # 5867
Name Heartland Drilling, Inc.
City/State Wichita, KS 67202

Nearest lease or unit boundary line 660 feet.
County Barber

Lease Name Z. Bar Ranch Well# 5-1

Well Drilled For: Well Class: Type Equipment:
 Oil Swd Infield Mud Rotary
 Gas Inj Pool Ext. Air Rotary
 OWWO Expl Wildcat Cable

Domestic well within 330 feet: yes no
Municipal well within one mile: yes no

If OWWO: old well info as follows:

Depth to Bottom of fresh water 30 feet
Lowest usable water formation Quaternary
Depth to Bottom of usable water 200 feet

Operator
Well Name
Comp Date Old Total Depth
Projected Total Depth 5000' feet
Projected Formation at TD Mississippian
Expected Producing Formations Mississippian

Surface pipe by Alternate: 1 2
Surface pipe to be set 220' feet
Conductor pipe if any required 80 feet
Ground surface elevation feet MSL
This Authorization Expires 4-11-85
Approved By Res. King 84 10-11-84

I certify that we will comply with K.S.A. 55-101, et seq., plus eventually plugging hole to K.C.B. specifications. Kwas 1980 FEL

Date 10/16/84 Signature of Operator or Agent Charles R. King Title


President

Charles R. King

Must be filed with the K.C.C. five (5) days prior to commencing well
This card void if drilling not started within six (6) months of date received by K.C.C.

Important procedures to follow:

A Regular Section of Land
1 Mile = 5,280 Ft.

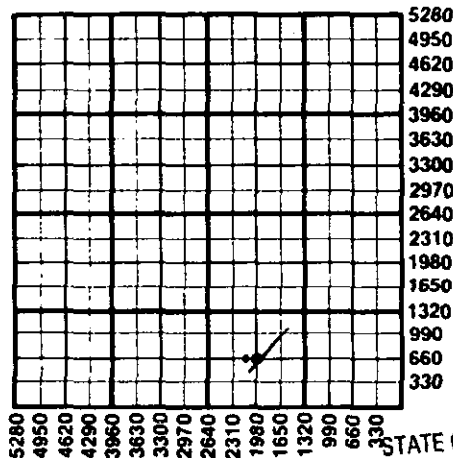

1. Notify District office before setting surface casing.
2. Set surface casing by circulating cement to the top.
3. File completion forms ACO-1 with K.C.C. within 90 days of well completion, following instructions on ACO-1, side 1, and including copies of wireline logs.
4. Notify District office 48 hours prior to old well workover or re-entry.
5. Prior to plugging, prepare a plugging plan, then obtain agreement from the appropriate district office for an approved plugging plan.
6. Submit plugging report (CP-4) to K.C.C. after plugging is completed.
7. Obtain an approved injection docket number before disposing of salt water.
8. Notify K.C.C. within 10 days when injection commences or terminates.
9. If an alternate 2 completion, cement in the production pipe from below by usable water to surface within 120 days of spud date.

RECEIVED
STATE CORPORATION COMMISSION

OCT 17 1984
10-17-84
CONSERVATION DIVISION
Wichita, Kansas

State Corporation Commission of Kansas
Conservation Division
200 Colorado Derby Building
Wichita, Kansas 67202
(316) 263-3238