

CARD MUST BE TYPED

State of Kansas
NOTICE OF INTENTION TO DRILL
(see rules on reverse side)

CARD MUST BE SIGNED

Starting Date: October 2, 1984
month day year

API Number 15- 007-21,933-0000

OPERATOR: License # 5601
Name Associated Petroleum Consultants, Inc.
Address Suite 600 - One Main Place
City/State/Zip Wichita, KS 67202 - 1399
Contact Person Steve Wisotsky
Phone (316) 265-9385

East
C. SE NE. . . . Sec 10. . Twp 35. . S, Rge .15. West
(location)

3300' Ft North from Southeast Corner of Section
600' Ft West from Southeast Corner of Section
(Note: Locate well on Section Plat on reverse side)

CONTRACTOR: License # 5867
Name Heartland Drilling, Inc.
City/State Wichita, KS 67202-1399

Nearest lease or unit boundary line 660 feet.
County Barber
Lease Name Z. Bar Ranch Well# 1-10

Domestic well within 330 feet : yes no
Municipal well within one mile : yes no

Well Drilled For: **Well Class:** **Type Equipment:**
 Oil Swd Infield Mud Rotary
 Gas Inj Pool Ext. Air Rotary
 OWWO Expl Wildcat Cable

Depth to Bottom of fresh water 200 feet
Lowest usable water formation Quaternary
Depth to Bottom of usable water 200 feet
Surface pipe by Alternate : 1 2

If OWWO: old well info as follows:
Operator
Well Name
Comp Date Old Total Depth
Projected Total Depth 5600' feet
Projected Formation at TD Simpson
Expected Producing Formations Mississippi

Surface pipe to be set 220' - 10 3/4" feet
Conductor pipe if any required None feet
Ground surface elevation 1600 feet MSL
This Authorization Expires 3-25-85
Approved By 9-25-84

I certify that we will comply with K.S.A. 55-101, et seq., plus eventually plugging hole to K.C.C. specifications.

Date 9/24/84 Signature of Operator or Agent


Charles R. King
Charles R. King

Title President

Must be filed with the K.C.C. five (5) days prior to commencing well
This card void if drilling not started within six (6) months of date received by K.C.C.

Important procedures to follow :

A Regular Section of Land
1 Mile = 5,280 Ft.

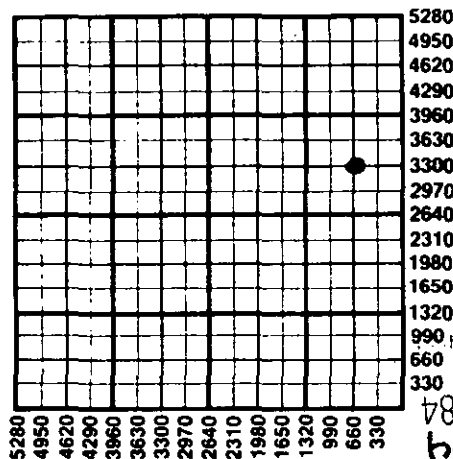

1. Notify District office before setting surface casing.
2. Set surface casing by circulating cement to the top.
3. File completion forms ACO-1 with K.C.C. within 90 days of well completion, following instructions on ACO-1, side 1, and including copies of wireline logs.
4. Notify District office 48 hours prior to old well workover or re-entry.
5. Prior to plugging, prepare a plugging plan, then obtain agreement from the appropriate district office for an approved plugging plan.
6. Submit plugging report (CP-4) to K.C.C. after plugging is completed.
7. Obtain an approved injection docket number before disposing of salt water.
8. Notify K.C.C. within 10 days when injection commences or terminates.
9. If an alternate 2 completion, cement in the production pipe from below any usable water to surface within 120 days of spud date.

State Corporation Commission of Kansas
Conservation Division
200 Colorado Derby Building
Wichita, Kansas 67202
(316) 263-3238