

To:
STATE CORPORATION COMMISSION
CONSERVATION DIVISION - PLUGGING SECTION
200 COLORADO DERBY BUILDING
WICHITA, KANSAS 67202

API NUMBER 15-007-20,732-0000

SW, Sec. 11, T 35S, R 11 W/4

_____ feet from N/S section line

_____ feet from W/E section line

TECHNICIAN'S PLUGGING REPORT

Operator License # 6006

Lease Name Alder Well # 1

Operator:
Name & Address Molz Oil Co
R.R. 2 Box 54
Kiowa, KS. 67070

County Barber

Well Total Depth 4792 feet 155.74

Conductor Pipe: Size _____ feet

Surface Casing: Size 10 3/4 feet 352 w/350sv

Abandoned Oil Well Gas Well Input Well _____ SWD Well _____ D&A _____

Other well as hereinafter indicated _____

Plugging Contractor Clark Corporation License Number 5105

Address 107 W. Fowler Medicine Lodge 67104

Company to plug at: Hour: 3:00 pm Day: 3 Month: March Year: 1983

VERBAL PLUGGING ORDERS GIVEN TO Elmo Morgenstern

(company name) Clark Corporation (phone) _____

were: 1st Plug Pumped 35 sx on bottom

2nd Plug 3 hull - 15 gel - 70 sx cements - 20 gel

1 hull - 1 plug - 160 sx cement

Perforations at 4776 - 4792 open hole

Signed Richard W. Lacey
(TECHNICIAN)

Plugging Operations attended by Agent?: All Part _____ None _____

Operations Completed: Hour: 4:00 pm Day: 3 Month: March Year: 1983

ACTUAL PLUGGING REPORT Plugged as ordered in above paragraph

Maximum Pump Pressure 400 psi

Shut in Pressure 300 psi

Recovered 3634' of 4 1/2" production casing

Recovered 418' of 8 5/8" surface pipe

Allied did the cementing work

Remarks: Mr. Paul Luthi witnessed the plugging operations

I hereby certify that the above plugging instructions were given as herein stated and that I (~~did~~/ did not) observe this plugging.

INVOICED

DATE 0. 4126-W

RECEIVED
STATE CORPORATION COMMISSION

Signed Richard W. Lacey
(TECHNICIAN)

MAR 8 1983
3-8-83
CONSERVATION DIVISION
Wichita, Kansas

FORM CP-2/3
Rev. 9-82

15-007-20732-0000
LAUGHLIN-SIMMONS & CO. OF KANSAS, INC.
OIL FIELD SURVEYING
1337 NORTH MERIDIAN, SUITE 2 WICHITA, KANSAS 67203 (316) 943-5351

KW0315797

INVOICE NO.

3-23-79

DATE

Barber 11 35s 11w

COUNTY

S T R

140' FSL 2380' EEL of SW1/4

LOCATION

Molz Oil Company

1

Alder

OPERATOR

NO.

FARM

ELEVATION:

1313 gr

Molz Oil Company
R. R. 2
Box 54
Kiowa, Kansas 67070

AUTHORIZED BY:


Jim Molz

PHONE #

1-296-4558

verify-need 1st nxt wk

SCALE: 2" = 1 Mile

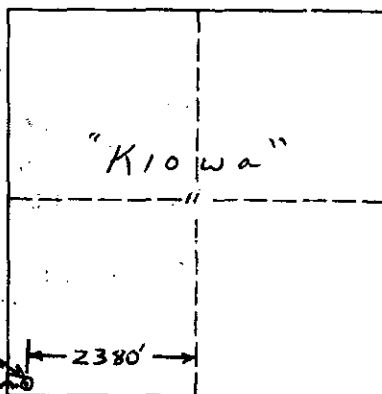

Verified location as
though staking.

MINIMUM STAKING CHARGE:
(INCLUDES GROUND ELEVATION)

\$95.00

EXTRA TIME & MILEAGE:

ELEVATION CHARGE:

32

TOTAL:

\$95.00

Thank You!

Jim Johnson
L-S SURVEYOR

Laughlin-Simmons & Co. of Kansas, Inc. is not liable in case of errors and/or omissions.