

9-11

35  
R

040317

To: STATE CORPORATION COMMISSION  
CONSERVATION DIVISION - PLUGGING SECTION App.  
200 COLORADO DERBY BUILDING  
WICHITA, KANSAS 67202

API NUMBER 15-007-20,897-0000  
SW NW SE, SEC. 8, T 35 S, R 12 W/E

1790 feet from S section line  
2080 feet from E section line

TECHNICIAN'S PLUGGING REPORT

Operator License # 6006

Lease Name SE Hardtner Well # 1

Operator: Molz Oil  
Name & Address: RFD #2, Box 54  
Kiowa, KS 67070

County Barber 157.14

Well Total Depth 4835 feet

Conductor Pipe: Size \_\_\_\_\_ feet

Surface Casing: Size 10 3/4 feet 344

Abandoned Oil Well  Gas Well \_\_\_\_\_ Input Well \_\_\_\_\_ SWD Well \_\_\_\_\_ D&A \_\_\_\_\_

Other well as hereinafter indicated \_\_\_\_\_

Plugging Contractor Clarke Corporation License Number 5105

Address Box 187, Medicine Lodge, KS 67104

Company to plug at: Hour: 11 a.m. Day: 11 Month: 9 Year: 19 89

Plugging proposal received from Elmo Morgenstern

(company name) Clarke Corporation (phone) 316-886-5665

were: 4 1/2" at 4823' Open hole at 4823-4835'

1st plug pump 45 sx common cement and one sx hulls to 4000',

2nd plug pump 400 lbs. hulls, 10 sx gel, 50 sx cement, 10 sx gel, 1 sx hulls, and 130 sx cement.

RECEIVED  
SEP 18 1989  
9-18-89  
Wichita, Kansas

Plugging Proposal Received by Mike Wilson (TECHNICIAN)

Plugging Operations attended by Agent?: All  Part \_\_\_\_\_ None \_\_\_\_\_

Operations Completed: Hour: 11:45 a.m. Day: 11 Month: 9 Year: 19 89

ACTUAL PLUGGING REPORT 1st plug pumped bottoms with 45 sx common cement, stopped plug at 4050'. Pressure = 2800 psi.

2nd plug pumped down 10 3/4" surface pipe with 400 lbs. hulls, 10 sx gel, 50 sx cement, 10 sx gel, 100 lbs. hulls, and 130 sx cement.

Maximum pressure 300 psi and shut in 300 psi.

Recovered 3800' of 4 1/2" casing.

Remarks: Used common cement and 60/40 Pozmix 6% gel by B.J. Titan.  
(If additional description is necessary, use BACK of this form.)

INVOICED  
I did not observe this plugging.

DATE 9-22-89

Signed Stephen J. Pfeifer (TECHNICIAN) R.W.L.

INV. NO. 25937

15-007-20897-0000

TEMPERATURE SURVEYS

Send the following information with temperature survey charts:

Date 3-1-80 Place HARDTNER KS

Company Name MOLZ Oil Co Order No. \_\_\_\_\_


Mailing Address RR 2 Box 54 City MOLWA State KS 67070

Owner of Well SAME Contractor SWEETMAN OILG.

Well No. 1 Farm S.E. HARDTNER Townsite \_\_\_\_\_ County BARBER Sec. 8 Twp. 35 Rge. 12 W

Depth of Well \_\_\_\_\_ Depth of Casing 4823 New  or Used \_\_\_\_\_ Size 4 1/2 Weight \_\_\_\_\_ Size of Hole 7 3/8 Amount of Cement 175 Kind of Cement 18% SALT

Survey From 11' BELOW K.B To 4777

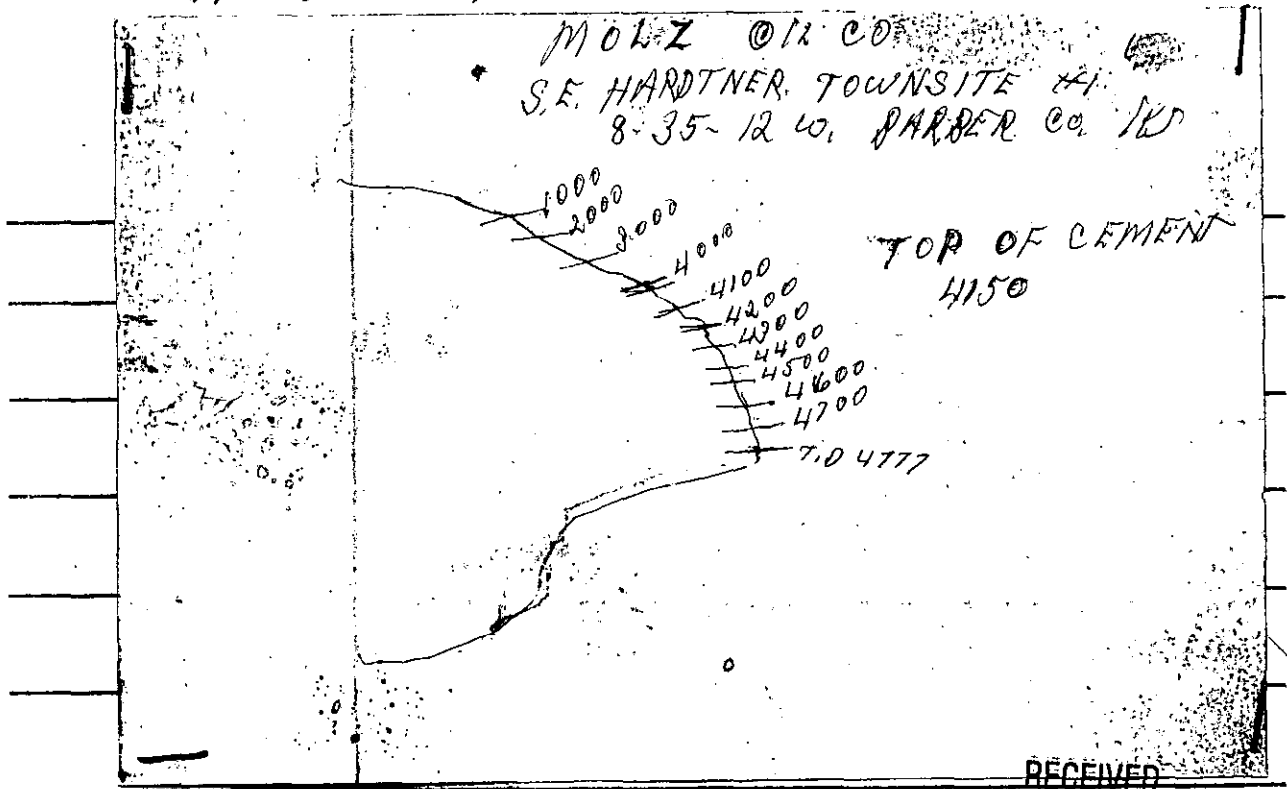

RECEIVED  
STATE CORPORATION COMMISSION

SEP 15 1989  
9-15-89  
CONSERVATION DIVISION  
Wichita, Kansas