


15-007-00403-0000

STATE OF KANSAS
STATE CORPORATION COMMISSION

Give All Information Completely
Make Required Affidavit
Mail or Deliver Report to:
Conservation Division
State Corporation Commission
800 Bitting Building
Wichita, Kansas

WELL PLUGGING RECORD

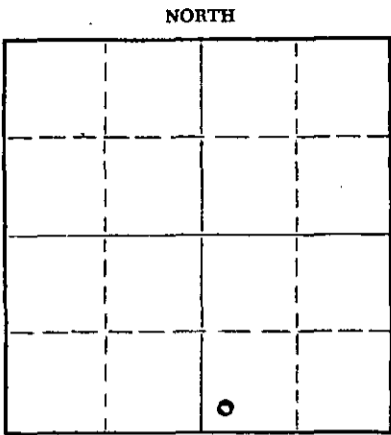

Barber County. Sec. 16 Twp. 30 Rge. 12 (W)
Location as "NE/CNW/SW" or footage from lines SW SW SE
Lease Owner National Associated Petroleum Company
Lease Name Henry Lawrenz Well No. 1
Office Address Ritz Bldg, Tulsa, Oklahoma
Character of Well (completed as Oil, Gas or Dry Hole) Dry Hole
Date well completed October 10, 1957 19
Application for plugging filed October 15, 1957 19
Application for plugging approved October 10, 1957 19
Plugging commenced 8:00 P.M. October 10, 1957 19
Plugging completed 12:00 P.M. October 10, 1957 19
Reason for abandonment of well or producing formation Dry Hole

If a producing well is abandoned, date of last production 19
Was permission obtained from the Conservation Division or its agents before plugging was commenced? Yes

Name of Conservation Agent who supervised plugging of this well Mr. M. A. Rives
Producing formation Depth to top Bottom Total Depth of Well 4722 Feet
Show depth and thickness of all water, oil and gas formations.

OIL, GAS OR WATER RECORDS

CASING RECORD

FORMATION	CONTENT	FROM	TO	SIZE	PUT IN	PULLED OUT
Lans - K.C.	Water	3834	4200	8 5/8	295"	None
Mississippi	Water	4362	4378			
Viola	Water	4494	4586			
Simpson Sand	Water	4604	4650			
Arbuckle	Water	4712	4722			

Describe in detail the manner in which the well was plugged, indicating where the mud fluid was placed and the method or methods used in introducing it into the hole. If cement or other plugs were used, state the character of same and depth placed, from feet to feet for each plug set.

4722' to 325' Heavy mud.
325' to 270' Cement plug.
270' to 15' Heavy mud.
15' to surface. Cement plug.

RECORDED
STATE CORPORATION COMMISSION
OCT 18 1957
WICHITA, KANSAS

(If additional description is necessary, use BACK of this sheet)

Name of Plugging Contractor Lewis Drilling Company
Address 915 Union Center Wichita, Kansas

STATE OF Kansas COUNTY OF McPherson ss.
Lawrence O. Tank, Jr. (employee of owner) or (owner) of the above-described well, being first duly sworn on oath, says: That I have knowledge of the facts, statements, and matters herein contained and the log of the above-described well as filed and that the same are true and correct. So help me God.

(Signature) Lawrence O. Tank, Jr.
Box 717 McPherson, Kansas
(Address)

SUBSCRIBED AND SWORN TO before me this 17th day of October, 1957

My commission expires November 24, 1960

Lucille Nevenschwander
Notary Public.

PLUGGING
FILE SEC 16 T 30 R 12W
BOOK PAGE 53 LINE 42