


STATE OF KANSAS
STATE CORPORATION COMMISSION

WELL PLUGGING RECORD

Give All Information Completely
Make Required Affidavit
Mail or Deliver Report to
Conservation Division
State Corporation Comm.
245 North Water
Wichita, KS 67202

FRANKLIN County, Sec. 27 Twp. 16 Rge. 21 E/W
Location as "NE/CNW/SW" or footage from lines
SW/4, 1150' FWL, 2460 FSL
Lease Owner McMullin Oil
Lease Name CHRISTENSON Well No. D-3
Office Address RR#2, MARCELINE, MO. 64658
Character of Well (Completed as Oil, Gas or Dry Hole) Dry Hole
Date Well completed 8-11 1978
Application for plugging filed 8-11 1978
Application for plugging approved 8-11 1978
Plugging commenced 8-12 1978
Plugging completed 8-12 1978
Reason for abandonment of well or producing formation Dry Hole
If a producing well is abandoned, date of last production N/A 19
Was permission obtained from the Conservation Division or its agents before plugging was commenced? Yes

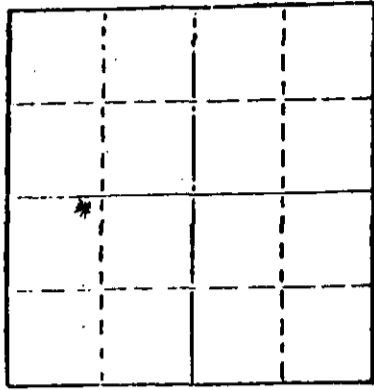

Name of Conservation Agent who supervised plugging of this well Jim Mc Daniels
Producing formation None Depth to top _____ Bottom _____ Total Depth of Well 728
Show depth and thickness of all water, oil and gas formations.

OIL, GAS OR WATER RECORDS

CASING RECORD

FORMATION	CONTENT	FROM	TO	SIZE	PUT IN	PULLED OUT
	<u>N/A</u>					

Describe in detail the manner in which the well was plugged, indicating where the mud fluid was placed and the method or methods used in introducing it into the hold. If cement or other plugs were used, state the character of same and depth placed, from _____ feet to _____ feet for each plug set. Mixed and Paired 10 Sacks of Portland Cement through Drill Stem at 225 feet Set Bridge at 30 feet and Paired 6 Sacks of Portland Cement Cut off Surface pipe and Filled with Dirt.

(If additional description is necessary, use BACK of this sheet)

Name of Plugging Contractor Finch Drilling Co.

STATE OF Missouri COUNTY OF Linn, ss.
Douglas J. McMullin (employee of owner) or (owner or operator)

of the above-described well, being first duly sworn on oath, says: That I have knowledge of the facts, statements, and matters herein contained and the log of the above-described well as filed and that the same are true and correct. So help me God.

(Signature) Douglas J. McMullin
RR2 Marceline, Mo. (Address)

SUBSCRIBED AND SWORN TO before me this 29th day of August, 1978.

My commission expires Oct 2 / 1980

RECEIVED
STATE CORPORATION COMMISSION
Notary Public.

AUG 31 1978
08-31-78
CONSERVATION DIVISION
Wichita, Kansas

Well LOG
 Well No. D-3 CHRISTENSON LEASE
 S-27, T-16, R21E DEE HOLE

Thickness	FORMATION	Total depth
7	TOPSOIL	7
11	LIME	18
7	Black shale	25
14	LIME 6 SKS. CEMENT	39
3	SANDSTONE	42
2	LIME	44
4	SHALE	48
13	LIME	61
38	SHALE	99
16	LIME	115
89	SHALE	204
21	LIME 70 SKS. CEMENT	225
27	SHALE	252
6	LIME	258
25	SHALE	283
16	LIME	299
20	SHALE	319
28	LIME	347
37	SHALE	384
24	LIME	408
4	SHALE (HERTHA)	412
13	LIME	425
14	SHALE	439
18	LIME	457
22	SHALE	479
19	LIME	498
15	SHALE	513
