


15-007-20134-0000

WELL PLUGGING RECORD

Give All Information Completely  
Make Required Affidavit  
Mail or Deliver Report to:  
Conservation Division  
State Corporation Commission  
212 No. Market  
Wichita, Kansas

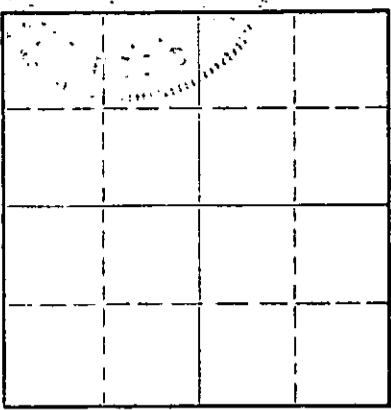

Locate well correctly on above  
Section Plat

Barber County, Sec. 34 Twp. 30S Rge. 12 (X) W (W)  
Location as "NE/CNWSW" or footage from lines. Approx. E/2 NW NE  
Lease Owner Kathol Petroleum, Inc.  
Lease Name Kimsey Well No. 1  
Office Address 900 Sutton Place, Wichita, Kansas  
Character of Well (completed as Oil, Gas or Dry Hole) Dry Hole  
Date well completed December 11 1969  
Application for plugging filed 19  
Application for plugging approved 19  
Plugging commenced December 11 1969  
Plugging completed December 11 1969  
Reason for abandonment of well or producing formation Dry Hole

If a producing well is abandoned, date of last production 19  
Was permission obtained from the Conservation Division or its agents before plugging was commenced? Yes

Name of Conservation Agent who supervised plugging of this well Herman Justus  
Producing formation \_\_\_\_\_ Depth to top \_\_\_\_\_ Bottom \_\_\_\_\_ Total Depth of Well 3760 Feet  
Show depth and thickness of all water, oil and gas formations.

OIL, GAS OR WATER RECORDS CASING RECORD

FORMATION	CONTENT	FROM	TO	SIZE	PUT IN	PULLED OUT
				8 5/8	263	None

Describe in detail the manner in which the well was plugged, indicating where the mud fluid was placed and the method or methods used in introducing it into the hole. If cement or other plugs were used, state the character of same and depth placed, from \_\_\_\_\_ feet to \_\_\_\_\_ feet for each plug set.

Filled hole to 260' w/heavy mud.  
Set plug + 1/3 sx. hull + 25 sx. cem.  
Filled hole to 40' w/heavy mud.  
Set plug + 1/3 sx. hulls + 10 sx. cem.  
to surface.


RECEIVED  
STATE CORPORATION COMMISSION  
JAN 5 1969  
CONSERVATION DIVISION  
Wichita, Kansas

(If additional description is necessary, use BACK of this sheet)  
Name of Plugging Contractor Kathol Petroleum, Inc.  
Address 900 Sutton Place, Wichita, Kansas

STATE OF KANSAS, COUNTY OF SEDGWICK, ss.  
Homer J. Catt (owner or operator) of the above-described well, being first duly sworn on oath, says: That I have knowledge of the facts, statements, and matters herein contained and the log of the above-described well as filed and that the same are true and correct. So help me God.

(Signature) Homer J. Catt  
900 Sutton Place, Wichita, Kansas  
(Address)

SWORN to before me this 31st day of December, 1969  
Dixie Lee Brown  
Notary Public.

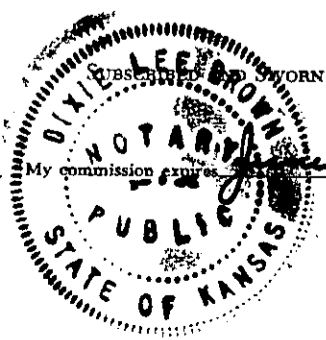

DRILLERS LOG

#1 KIMSEY

CASING RECORD:	OPERATOR:	Kathol Petroleum, Inc.	DESCRIPTION:
8 5/8" @ 263' w/ 200 sacks cem.	CONTRACTOR:	Kathol Petroleum, Inc.	40' S. & 135' E. of E/2 NW NE Section 34-30S-12W Barber Co., Kansas
TOTAL DEPTH:	COMMENCED:	December 3, 1969	
3761' L.T.D.	COMPLETED:	December 11, 1969	
	I.P. Plugged and Abandoned		Elev. 1698' K.B.

<u>FORMATION</u>	<u>FROM</u>	<u>TO</u>	<u>REMARKS</u>
red bed	0	70	
shale	70	263	
red bed & shale	263	1265	
shale & lime	1265	1785	
lime & shale	1785	1990	
shale & lime	1990	2210	
lime & shale	2210	2370	
shale & lime	2370	3030	
lime & shale	3030	3383	
shale & lime	3383	3539	
lime & shale	3539	3630	
shale & lime	3630	3640	
shale & sand	3640	3670	
sand & lime	3670	3730	
lime	3730	3760 R.T.D.	

RECEIVED  
STATE CORPORATION COMMISSION  
1-5-69  
JAN 5 1969  
CONSERVATION DIVISION  
Wichita, Kansas

I hereby certify that the above information is true and correct to the best of my knowledge.

KATHOL PETROLEUM, INC.

*Larry L. Taylor*  
Larry L. Taylor

Subscribed and sworn to before me this 31st day of December, 1969.

*Betty M. Malohey*  
Betty M. Malohey, Notary Public

My Commission Expires:

3/22/71

