


STATE OF KANSAS
STATE CORPORATION COMMISSION

WELL PLUGGING RECORD

Give All Information Completely
Make Required Affidavit
Mail or Deliver Report to
Conservation Division
State Corporation Comm.
245 North Water
Wichita, KS 67202

Barber County, Sec. 32 Twp. 30S Rge. 12W E/W
Location as "NE/CNW $\frac{1}{4}$ SW $\frac{1}{4}$ " or footage from lines
C SW NW

Lease Owner Raymond Oil Company
Lease Name Hazelton Land Company Well No. 1
Office Address One Main Place, Suite 900
Character of Well (Completed as Oil, Gas or Dry Hole) dry ;hole
Date Well completed 4-24-80 19
Application for plugging filed 4-24-80 19
Application for plugging approved 4-24-80 19
Plugging commenced 4-24-80 19
Plugging completed 4-24-80 19
Reason for abandonment of well or producing formation

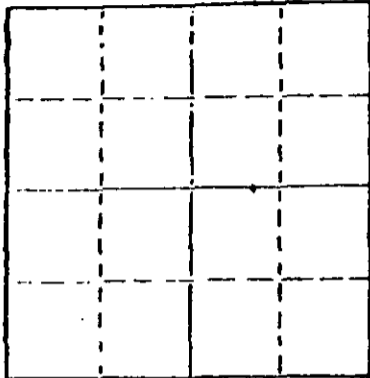

Locate well correctly on above
Section Plat

If a producing well is abandoned, date of last production 19

Was permission obtained from the Conservation Division or
its agents before plugging was commenced? yes

Name of Conservation Agent who supervised plugging of this well Bill Owen
Producing formation Depth to top Bottom Total Depth of Well 3910
Show depth and thickness of all water, oil and gas formations.

OIL, GAS OR WATER RECORDS

CASING RECORD

FORMATION	CONTENT	FROM	TO	SIZE	PUT IN	PULLED OUT
Surface	8 5/8	0	276	8 5/8	276	0

Describe in detail the manner in which the well was plugged, indicating where the mud fluid
was placed and the method or methods used in introducing it into the hold. If cement or other
plugs were used, state the character of same and depth placed, from feet to
feet for each plug set.

First plug @ 270' w/40 sx common
Second plug @ 40' w/10 sx & $\frac{1}{2}$ sx hulls
5 sx in rathole

RECEIVED

JUN 10 1980
6-10-80

(If additional description is necessary, use BACK of this sheet)

Name of Plugging Contractor Allied Cementing Co., Inc.

STATE OF Kansas COUNTY OF Sedgwick, ss.
Timothy E. Brandt (employee of owner) or (owner or operator)
of the above-described well, being first duly sworn on oath, says: That I have knowledge of
the facts, statements, and matters herein contained and the log of the above-described well
as filed and that the same are true and correct. So help me God.

(Signature) [Signature]
1200 Douglas Building Wichita, Kansas
(Address)

SUBSCRIBED AND SWORN TO before me this 6th day of June, 19 80

[Signature]
Debra L Heersche Notary Public.

My commission expires March 3, 1984

