

STATE OF KANSAS
STATE CORPORATION COMMISSION
CONSERVATION DIVISION
P. O. BOX 17027
WICHITA, KANSAS 67217

WELL PLUGGING RECORD

Barber County, Sec. 3 Twp. 35s Rge. (E) 15 (W)

Location as "NE/CNWKSW" or footage from lines NE SE NW

Lease Owner Braden Deem

Lease Name Davis Ranch Well No. 1-3

Office Address 200 East First Wichita Kansas 67202

Character of Well (completed as Oil, Gas or Dry Hole) Gas

Date well completed 7 / 30 19 62

Application for plugging filed 1 / 24 19 75

Application for plugging approved 2 / 6 19 75


Plugging commenced 3 / 13 19 75

Plugging completed 3 / 26 19 75

Reason for abandonment of well or producing formation dry

If a producing well is abandoned, date of last production 1 / 19 75

Was permission obtained from the Conservation Division or its agents before plugging was commenced? yes

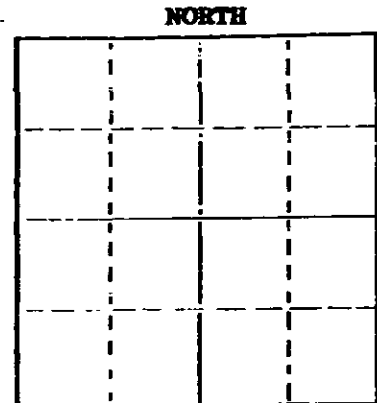

Locate well correctly on above Section Plot

Name of Conservation Agent who supervised plugging of this well G. R. Hiberstein

Producing formation Miss. Depth to top 4862 Bottom 4887 Total Depth of Well 4962

Show depth and thickness of all water, oil and gas formations.

OIL, GAS OR WATER RECORDS

CASING RECORD

FORMATION	CONTENT	FROM	TO	SIZE	PUMP IN	PULLED OUT
	Surface	0	230	13 3/8		
	Surface	0	1121	8 5/8		
		0	4961	5 1/2		4123.18

Describe in detail the manner in which the well was plugged, indicating where the mud fluid was placed and the method or methods used in introducing it into the hole. If cement or other plugs were used, state the character of same and depth placed, from _____ feet to _____ feet for each plug set.

Filled with sand to 4850 dumped 5 sx. cement

Plug with rock and sand at 200 ft. filled to bottom of cellar with 3 yards of readymix cement

(If additional description is necessary, use BACK of this sheet)

Name of Plugging Contractor Nicholas Casing Pulling

Address Box 373 Geneseo Kansas 67444

STATE OF KANSAS COUNTY OF RICE, SE.

George A. Nicholas (employee of owner) or (owner or operator) of the above-described

well, being first duly sworn on oath, says: That I have knowledge of the facts, statements, and matters herein contained and the log of the above-described well as filed and that the same are true and correct. So help me God.

(Signature) George A. Nicholas

WARREN H. LAUGHLIN

NOTARY PUBLIC

Rice County, Kansas

My Commission Expires

September 24, 1978

before me this 27th

day of March

(Address) 19 75

Warren H. Laughlin

Notary Public

RECEIVED
STATE CORPORATION COMMISSION

MAR 28 1975
3-28-75
CONSERVATION DIVISION
Wichita, Kansas

RECEIVED
STATE CORPORATION COMMISSION

JAN 27 1965
1-27-75
CONSERVATION DIVISION
Wichita, Kansas

DRILLER'S LOG

Braden Drilling, Inc. et al
DAVIS RANCH #1-3
NE/4 SE/4 NW/4 Sec. 3-35S-15W
Barber County, Kansas

Commenced: July 2, 1962
Completed: July 30, 1962

Set 13-1/8" casing at 230' and cemented
with 250 sacks cement.

Set 8-5/8" casing at 1121' and cemented
with 600 sacks cement.

Set 5-1/2" casing at 4961' and cemented
with 100 sacks cement.

Surface sand and shale	30 feet
Red rock	230
Shale and red rock	735
Red bed	840
Salt shale	1100
Shale - Anhydrite	1252
Shale and shells, salt	1825
Shale and lime	2020
Lime	2160
Shale and lime	4185
Lime	4440
Lime and chalk	4485
Lime	4825
Cherokee	4862
Mississippi Lime	4875
Lime	4895
Lime and chert	4915
Lime	4965 Total Depth

I, F. M. Callaway, Secretary-Treasurer of Braden Drilling, Inc., hereby certify that this is a true and correct log of the above captioned well, as shown by the daily drilling reports.

F. M. Callaway
F. M. Callaway

Subscribed and sworn to before me this 1st day of August, 1962.

My commission expires March 21, 1966.

Notary Public
Notary Public